HARRISON
G204
6-8-73

MISSISSIPPI
BOARD OF WATER COMMISSIONERS
416 North State Street
Jackson, Mississippi 39201

CODED

WATER WELL DRILLERS LOG

June 8 1973 H.A. Ladwig's Well Co. Harrison
date well completed — firm name — county well located

LANDOWNER: Mr. Hollandman
Hollimann ?

Lyman Miss.
(mailing address)

WELL LOCATION:
sec. 2 T 6 S R 11 W

2 miles NE of Lyman
(distance) (direction) (nearest town)

WELL PURPOSE: none
(home, irrigation, municipal, industrial)

WELL COMPLETION DATA:

(1) diameter (inches) 8 inch
(2) total depth (feet) 220 ft.
(3) static water level (feet) 30 below ~~above~~ top of ground.
(4) casing Galv. (material), 210 ft. (depth)
2 in (size) if telescope see back.
(5) screen 10 ft (length), 210 ft. (depth to top)
2 in (size), S. Steel (material)
(6) pump 1 (HP) 7 (yield gpm)
Elect. (type power)
(7) electric log No (yes or no)
(organization running log)
(8) how well bottom plugged BALLCHECK

DRILLERS REMARKS:

description of formations encountered	from	to
Red Clay	0	20
Blue Clay	20	190
Blue Sand	190	220

JUL 30 [redacted]

If well telescopes please sketch and show depths.

GROUND LEVEL

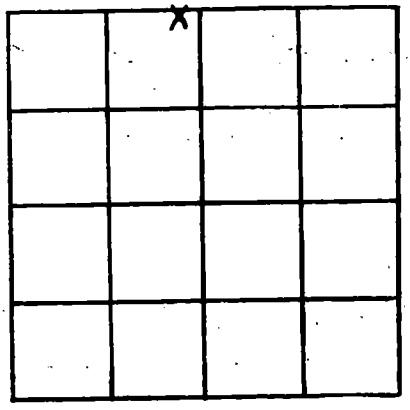

SECTION 2

Please indicate well location X.

ADDITIONAL INFORMATION

If more than one screen, show locations of each on sketch.