HARRISON
G 210
1-5-74

MISSISSIPPI
BOARD OF WATER COMMISSIONERS
416 North State Street
Jackson, Mississippi 39201

WATER WELL DRILLERS LOG

1-5-74 19 — R. T. Moore — HARRISON
date well completed — firm name — county well located

LANDOWNER: JACK WRIGHT
RT #1 Box 515
SHUCKER, MISS 39574
(mailing address)

WELL LOCATION:
sec. 5 T 6 N (S) R 11 E (W)
3 miles N of LYMAN
(distance) (direction) (nearest town)

WELL PURPOSE:
(home, irrigation, municipal, industrial)

WELL COMPLETION DATA:
(1) diameter (inches) 2"
(2) total depth (feet) 452'
(3) static water level (feet) 60' below above top of ground.
(4) casing PVC (material), 442' (depth)
(size) If telescope see back.
(5) screen 10' (length), 442' (depth to top)
2" (size), S (material)
(6) pump 1 (HP) 8 (yield gpm)
E (type power)
(7) electric log (yes or no)
(organization running log)
(8) how well bottom plugged B W Value

DRILLERS REMARKS:

description of formations encountered	from	to
Top Soil	0	10
Red Sand + Clay	10	18
Red + White Clay	18	70
Blue Clay	70	300
Fine Grey Sand	300	330
Blue Clay	330	410
Coarse Grey Sand	410	452

CODED

RECEIVED
MISS. BOARD OF WATER COMMISSIONERS

If well telescopes please sketch and show depths.

GROUND LEVEL

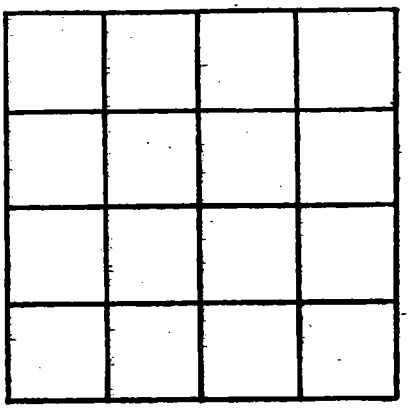

SECTION _____

Please indicate well location X.

ADDITIONAL INFORMATION

If more than one screen, show locations of each on sketch.