HARRISON
G216
6-15-74

MISSISSIPPI
BOARD OF WATER COMMISSIONERS
416 North State Street
Jackson, Mississippi 39201

CODED

# WATER WELL DRILLERS LOG

6-15-74 19 — date well completed
R. T. Moore — firm name
HARRISON — county well located

LANDOWNER: H. Mersner
LYMAN Hwy 49
(mailing address)

WELL LOCATION:
sec. 29 T. 6 N (S) R. 11 E (W)
1/2 (distance) miles N (direction) of LYMAN (nearest town)

WELL PURPOSE:
(home, irrigation, municipal, industrial)

WELL COMPLETION DATA:

(1) diameter (inches) 2"
(2) total depth (feet) 500'
(3) static water level (feet) 55' (below) above top of ground.
(4) casing PVC (material), 490' (depth),
(size) If telescope see back.
(5) screen 10' (length), 490' (depth to top)
2" (size), SS (material)
(6) pump 1 (HP) 10 (yield gpm)
E (type power)
(7) electric log (yes or no)
(organization running log)
(8) how well bottom plugged
Bed Chips

DRILLERS REMARKS:

| description of formations encountered | from | to |
|---|---|---|
| TOP SOIL | 0 | 10 |
| Red white Clay | 10 | 60 |
| Red Clay | 60 | 70 |
| Blue Clay | 70 | 420 |
| FINE SAND | 420 | 460 |
| Coarse Sand | 460 | 500 |

MISS. BD. OF WATER COMMISSIONERS

If well telescopes please sketch and show depths.

GROUND LEVEL

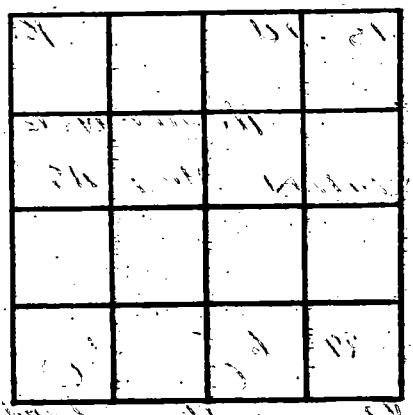

SECTION _____

Please indicate well location X.

ADDITIONAL INFORMATION

If more than one screen, show locations of each on sketch.