

HARRISON
G217
8/16/74

MISSISSIPPI
 BOARD OF WATER COMMISSIONERS
 416 North State Street
 Jackson, Mississippi 39201

CODED

WATER WELL DRILLERS LOG

8-~~20~~16-74 19 R. J. Moore HARRISON
 date well completed firm name county well located

LANDOWNER: Jack Rose
RT #8 GLENN, MS
Box 1096
 (mailing address)

WELL LOCATION:
 sec 26 T 6 N R 11 E
2 miles E of LYMAN
 (distance) (direction) (nearest town)

WELL PURPOSE:
 home irrigation, municipal, industrial

WELL COMPLETION DATA:

(1) diameter (inches) 2"

(2) total depth (feet) 536'

(3) static water level (feet) 47' below top of ground

(4) casing galv 526'
 (material) (depth)

 If telescope see back.
 (size)

(5) screen 10' 526"
 (length) (depth to top)

2" SS
 (size) (material)

(6) pump
 (HP) (yield gpm)

 (type power)


(7) electric log
 (yes or no)

 (organization running log)

(8) how well bottom plugged

description of formations encountered	from	to
TOP SOIL	0	10
White sand	10	18
Clay	18	200
SILT	200	250
Clay	250	280
Med sand	28	470
FINE sand	470	570
Med sand	510	536

CODED

 


SEP 16 1974

DRILLERS REMARKS:

MISS. BD. OF WATER COMM

If well telescopes please sketch and show depths.

GROUND LEVEL

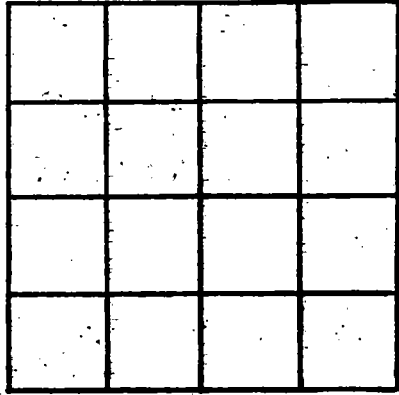

SECTION _____

Please indicate well location X.

ADDITIONAL INFORMATION

If more than one screen, show locations of each on sketch.