Harrison Co
G247
1/15/84

MISSISSIPPI DEPARTMENT OF NATURAL RESOURCES

Bureau of Land and Water Resources
Southport Mall
P.O. Box 10631
Jackson, Mississippi 39209

CODED

WATER WELL DRILLERS LOG

19 McGill Well Works Harrison
date well completed — firm name — county well located

LANDOWNER: Ms Forestry Comm
Harrison County Tower
Saucier, Ms.
(mailing address)

WELL LOCATION:
sec. 1 T 6 (S) R 11 E (W)
8 miles S of Success
(distance) (direction) (nearest town)

WELL PURPOSE: Residential
(home, irrigation, municipal, industrial)

WELL COMPLETION DATA:

(1) diameter (inches) 4½
(2) total depth (feet) 480
(3) static water level (feet) 150 below above top of ground.
(4) casing Poly (material), 480 (depth),
(size) if telescope see back.
(5) screen 20 ft (length), 460 (depth to top)
2in slot (size), stainless steel (material)
(6) pump 1 sub (HP) 20 (yield gpm)
electric (type power)
(7) electric log Yes (yes or no)
(organization running log)
(8) how well bottom plugged Shank & Back wash

DRILLERS REMARKS:

description of formations encountered	from	to
mud	0	20
Sand	20	40
Sand	40	60
Sand	60	80
mud	80	360
Sand & mud	360	380
Sand & mud	380	400
Sand	400	420
Sand	420	440
Sand	440	460
Sand	460	480

CODED

6 6"
40' 72"

DEPT OF NATURAL RESOURCES
BUREAU OF LAND & WATER RESOURCES
JAN 17 1984
RECEIVED

If well telescopes please sketch and show depths.

GROUND LEVEL

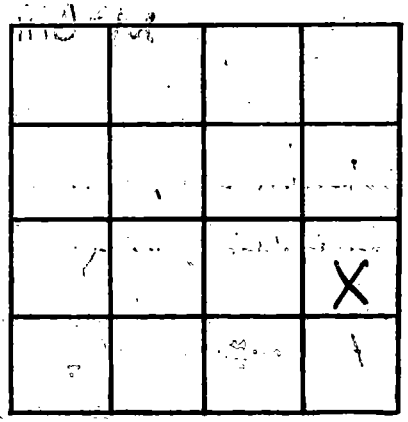

SECTION 1

Please indicate well location X.

ADDITIONAL INFORMATION

If more than one screen; show locations of each on sketch.