MISSISSIPPI DEPARTMENT OF NATURAL RESOURCES

Bureau of Land and Water Resources

P.O. Box 10631
Jackson, Mississippi 39209

WATER WELL DRILLERS LOG

COUNTY WELL LOCATED: Harrison	
WELL NUMBER: G	CODED:
2060	
DATE WELL COMPLETED: 9/2/86	
PERMIT NUMBER:	
NAME OF DRILLING FIRM: Lyman Well Co.	

NAME & MAILING ADDRESS OF LANDOWNER
Tommy Price
Rt. 13, Walter Smith Rd
Gulfport 39503

WELL LOCATION: SEC 21 TOWNSHIP 6 N RANGE 11 E (W)

DISTANCE 6 Miles DIRECTION North of NEAREST TOWN Gulfport

OTHER LANDMARK

WELL PURPOSE: (Home), Irrigation, Municipal, Industrial, Fish Pond, etc.

PUMP DATA

PUMP TYPE (Circle One): (Submersible), Turbine, Jet, Flowing Well, Other (Describe)

POWER TYPE (Circle One): (Electric), Tractor, Diesel, Gasoline, Butane, Other (Describe)

Pump Capacity (GPM)	No. of Stages	Setting Depth
18	8	100' FT.

PUMP TEST

Well yielded 18 GPM with a drawdown of N/A ft. after _____ hours of pumping

WELL DATA

Well Depth	Casing Diameter (In.)	Casing Length (Ft.)
215'	4"	205'

Type of Casing	Hole Depth	Depth to Static Water Level
PVC	215'	57'

TYPE OF COMPLETION: (Circle One or More): Gravel Packed, Underreamed, Telescoped, (Natural Development), Open Hole, Other (Describe)

Top of Lap Pipe or Reduction in Casing FEET

IF TELESCOPED OR MORE THAN ONE SCREEN: USE BACK PAGE

SCREEN DATA

Diameter - Inches	Length - Feet	Slot Size - Inches
4"	10'	.008

Screen Type	Depth to Bottom - Feet
PVC sawed	215'

LOG DATA

TYPE OF LOG RUN (Circle One): (No Log Run), Electric, Gamma Ray, Density, Sonic, Neutron, Other (Describe)

Name of Organization Running Log

GEOLOGIC DATA (Office Use Only)

Surface Elev.	Geologic Unit	Unit Thickness	Depth to Top
Subs. SWL	Date	Analysis	Aquifer Test

Driller's Remarks: None

DESCRIPTION OF FORMATIONS ENCOUNTERED	FROM	TO	FORMATIONS (Continued)	FROM	TO
Topsoil		1'			
Sand Clay	1'	5'			
Clay	5'	54'			
Sand	54	68'			
Blue Clay	68'	108'			
Sand	108	121			
Blue Clay	121	169			
Sand	169	215			
			IF MORE SPACE IS NEEDED, USE BACK		

RECEIVED
AUG 25 1987
Department of Natural Resources
Bureau of Land & Water Resources

If well telescopes please
sketch and show depths.

GROUND LEVEL

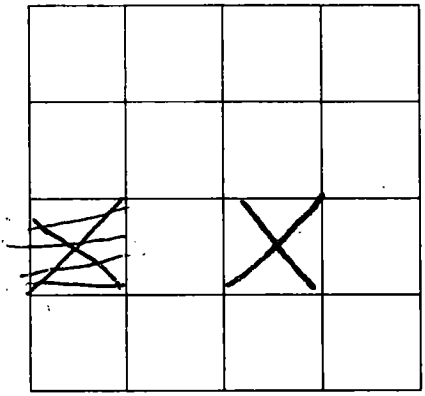

SECTION 21

Please indicate well location X.

ADDITIONAL INFORMATION

If more than one screen,
show location of each on sketch.