MISSISSIPPI DEPARTMENT OF NATURAL RESOURCES

Bureau of Land and Water Resources

P.O. Box 10631
Jackson, Mississippi 39209

WATER WELL DRILLERS LOG

COUNTY WELL LOCATED: Harrison	
WELL NUMBER: G 2070	CODED
DATE WELL COMPLETED: 10/8/87	
PERMIT NUMBER	
NAME OF DRILLING FIRM: Lyman Well Co	

NAME & MAILING ADDRESS OF LANDOWNER
Jim Thomas
15119 Mills Rd
Gpt. 39603

WELL LOCATION: SEC 19 TOWNSHIP 6 N RANGE 11 E W

DISTANCE 7 Miles DIRECTION North of NEAREST TOWN Gulfport

OTHER LANDMARK: None

WELL PURPOSE: Home, Irrigation, Municipal, Industrial, Fish Pond, etc.

PUMP DATA

PUMP TYPE (Circle One): Submersible, Turbine, Jet, Flowing Well, Other (Describe) _____

POWER TYPE (Circle One): Electric, Tractor, Diesel, Gasoline, Butane, Other (Describe) _____

Pump Capacity (GPM)	No. of Stages	Setting Depth
		FT.

PUMP TEST

Well yielded _____ GPM with a drawdown of _____ ft. after _____ hours of pumping

WELL DATA

Well Depth	Casing Diameter (In.)	Casing Length (Ft.)
194'	2"	184

Type of Casing	Hole Depth	Depth to Static Water Level
PVC	194'	38'

TYPE OF COMPLETION: (Circle One or More): Gravel Packed, Underreamed, Telescoped, Natural Development, Open Hole, Other (Describe) _____

Top of Lap Pipe or Reduction in Casing FEET

IF TELESCOPED OR MORE THAN ONE SCREEN: USE BACK PAGE

LOG DATA

TYPE OF LOG RUN (Circle One): No Log Run, Electric, Gamma Ray, Density, Sonic, Neutron, Other (Describe) _____

Name of Organization Running Log

GEOLOGIC DATA (Office Use Only)

Surface Elev.	Geologic Unit	Unit Thickness	Depth to Top
Subs. SWL	Date	Analysis	Aquifer Test

Driller's Remarks: None

SCREEN DATA

Diameter - Inches	Length - Feet	Slot Size - Inches
2"	10'	.006

Screen Type	Depth to Bottom - Feet
PVC Sawed slotted	195

DESCRIPTION OF FORMATIONS ENCOUNTERED	FROM	TO
Topsoil	0	1'
Sand & clay	1'	21'
Sand	21	25'
Clay & sand	25	178
Sand	178	194

FORMATIONS (Continued)	FROM	TO

IF MORE SPACE IS NEEDED, USE BACK

RECEIVED
FEB 22 1988
Department of Natural Resources
Bureau of Land & Water Resources

If well telescopes please sketch and show depths.

GROUND LEVEL

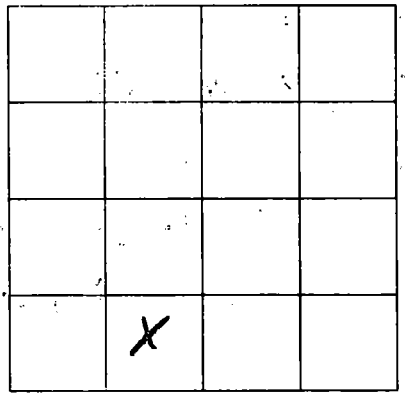

SECTION 19

Please indicate well location X.

ADDITIONAL INFORMATION

If more than one screen, show location of each on sketch.