MISSISSIPPI DEPARTMENT OF NATURAL RESOURCES

Bureau of Land and Water Resources

P.O. Box 10631
Jackson, Mississippi 39209

WATER WELL DRILLERS LOG

COUNTY WELL LOCATED: Harrison	PERMIT NUMBER
WELL NUMBER: G-2078 / CODED	NAME OF DRILLING FIRM: M & B Drilling Co.
DATE WELL COMPLETED: 3-15-90	

NAME & MAILING ADDRESS OF LANDOWNER
Mark Lampkin
14144 E. Lampkin Rd
Gulfport Miss. 39503

WELL LOCATION: SEC 25 TOWNSHIP 6 S RANGE 11 W

DISTANCE 3½ Miles DIRECTION E of NEAREST TOWN Lyman

OTHER LANDMARK

WELL PURPOSE: Home, Irrigation, Municipal, Industrial, Fish Pond, etc.
Home

PUMP DATA

PUMP TYPE (Circle One): Submersible, Turbine, Jet Flowing Well, Other (Describe) _____

POWER TYPE (Circle One): Electric, Tractor, Diesel, Gasoline, Butane, Other (Describe) _____ H/P 1

Pump Capacity (GPM)	No. of Stages	Setting Depth
25	9	60 FT.

PUMP TEST

Well yielded 25 GPM with a drawdown of _____ ft. after _____ hours of pumping

WELL DATA

Well Depth	Casing Diameter (In.)	Casing Length (Ft.)
220	4"	200

Type of Casing	Hole Depth	Depth to Static Water Level
PVC	220	25 FT

TYPE OF COMPLETION: (Circle One or More): Gravel Packed, Underreamed, Telescoped, Natural Development, Open Hole, Other (Describe) _____

Top of Lap Pipe or Reduction in Casing FEET

IF TELESCOPED OR MORE THAN ONE SCREEN: USE BACK PAGE

LOG DATA

TYPE OF LOG RUN (Circle One): No Log Run, Electric, Gamma Ray, Density, Sonic, Neutron, Other (Describe) _____

Name of Organization Running Log

GEOLOGIC DATA (Office Use Only)

Surface Elev.	Geologic Unit	Unit Thickness	Depth to Top
Subs. SWL	Date	Analysis	Aquifer Test

Driller's Remarks
10 FT 2" PVC Tail Pipe

SCREEN DATA

Diameter - Inches	Length - Feet	Slot Size - Inches
4"	10	.008

Screen Type	Depth to Bottom - Feet
PVC WOP	210

DESCRIPTION OF FORMATIONS ENCOUNTERED	FROM	TO	FORMATIONS ENCOUNTERED	FROM	TO
Clay	0	20			
Red Sand	20	60			
Blue Clay	60	190			
Coarse Gray Sand	190	210			
Blue Clay	210	220 +			
			IF MORE SPACE IS NEEDED, USE BACK		

RECEIVED
APR 02 1990
Department of Natural Resources
Bureau of Land & Water Resources

If well telescopes please sketch and show depths.

GROUND LEVEL

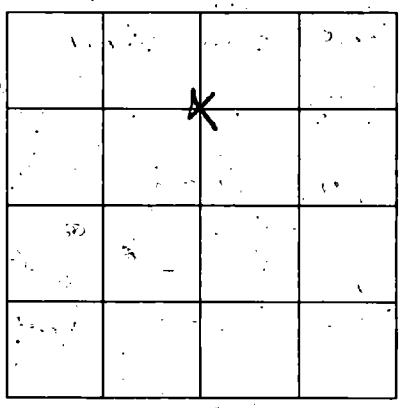

SECTION 25

Please indicate well location X.

ADDITIONAL INFORMATION

If more than one screen, show location of each on sketch.