MISSISSIPPI DEPARTMENT OF ENVIRONMENTAL QUALITY
Office of Land and Water Resources

P. O. Box 10631
Jackson, MS 39289-0631

WATER WELL DRILLERS LOG

COUNTY WELL LOCATED: Harrison	
WELL NUMBER: G 2126	CODED
DATE WELL COMPLETED: 8-8-97	
PERMIT NUMBER: 0404	
NAME OF DRILLING FIRM: Lyman Well Co	
Gpt, MS,	

NAME & MAILING ADDRESS OF LANDOWNER
Frank Sylvia
15032 Smiths Rd.
Gpt MS 39503

WELL LOCATION: SEC 19 TOWNSHIP 6 N/S RANGE 11 E/W

DISTANCE ____ Miles DIRECTION ____ of NEAREST TOWN ____

OTHER LANDMARK

WELL PURPOSE: Home, Irrigation, Municipal, Industrial, Fish Pond, etc.

PUMP DATA

PUMP TYPE (Circle One): Submersible, Turbine, Jet, Flowing Well, Other (Describe) ____

POWER TYPE (Circle One): Electric, Tractor, Diesel, Gasoline, Butane, Other (Describe) ____ H/P 1

Pump Capacity (GPM)	No. of Stages	Setting Depth
		60 FT.

PUMP TEST

Well yielded ____ GPM with a drawdown of ____ ft. after ____ hours of pumping

WELL DATA

Well Depth	Casing Diameter (in.)	Casing Length (Ft.)
240'	2"	
Type of Casing	**Hole Depth**	**Depth to Static Water Level**
PVC		40

TYPE OF COMPLETION: (Circle One or More): Gravel Packed, Underreamed, Telescoped, Natural Development, Open Hole, Other (Describe) ____

WELL GROUTED TO A DEPTH OF ____ FEET
Type Grout (circle one): Cement, Bentonite, or Mix

LOG DATA

TYPE OF LOG RUN (Circle One): No Log Run, Electric, Gamma Ray, Density, Sonic, Neutron, Other (Describe) ____

Name of Organization Running Log

GEOLOGIC DATA (Office Use Only)

Surface Elev.	Geologic Unit	Unit Thickness	Depth to Top
Subs SWL	Date	Analysis	Aquifer Test

Driller's Remarks

SCREEN DATA

Diameter - Inches	Length - Feet	Slot Size - Inches
2"	10'	.008
Screen Type		**Depth to Bottom - Feet**
PVC		

Top of Lap Pipe or Reduction in Casing ____ FEET

IF TELESCOPED OR MORE THAN ONE STRING, USE BACK PAGE

DESCRIPTION OF FORMATIONS ENCOUNTERED	FROM	TO

DESCRIPTION OF FORMATIONS ENCOUNTERED	FROM	TO
IF MORE SPACE IS NEEDED, USE BACK		

RECEIVED
DEC 08 1997
Dept. of Environmental Quality
Office of Land & Water Resources

If well telescopes please
sketch and show depths.

GROUND LEVEL

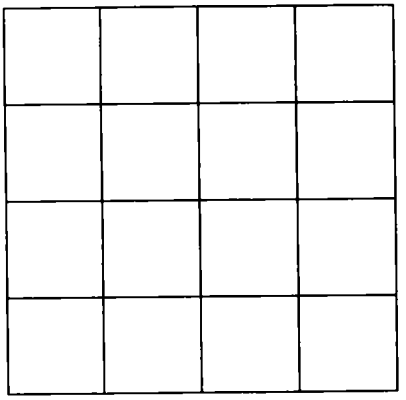

SECTION _____

Please indicate well location X.

ADDITIONAL INFORMATION

If more than one screen,
show location of each on sketch.