Harrison
H122
4-11-70

MISSISSIPPI
BOARD OF WATER COMMISSIONERS
416 North State Street
Jackson, Mississippi 39201

WATER WELL DRILLERS LOG

4-11-70 (date well completed) 19 C T Switzer Well Co. (firm name) Harrison (county well located)

LANDOWNER: Causey Hudson
Rt. 1 Box 776
Biloxi, Miss.
(mailing address)

WELL LOCATION:
sec. 8 T. 6 (S) R. 10 (W)
10 (distance) miles N (direction) of GULFPORT (nearest town)

WELL PURPOSE: Home
(home, irrigation, municipal, industrial)

WELL COMPLETION DATA:

(1) diameter (inches) 2"

(2) total depth (feet) 425'

(3) static water level (feet) 109 below ~~above~~ top of ground.

(4) casing galv. (material), 425' (depth),
_____ (size) If telescope see back.

(5) screen 10' (length), 415' (depth to top)
.008 (size), stainless steel (material)

(6) pump 1 (HP) 6.5 (yield gpm)
Elec. (type power)

(7) electric log No (yes or no)
_____ (organization running log)

(8) how well bottom plugged back pressure value

DRILLERS REMARKS:

description of formations encountered	from	to
CLAY	1	22
MIXED	22	46
SAND	46	54
CLAY	54	159
SAND	159	162
CLAY	162	302
SAND	302	312
CLAY	312	342
MIXED	342	362
CLAY	362	390
SAND	390	425

JUN 16 1970
MISS. BD. OF WATER COMM.

If well telescopes please sketch and show depths.

GROUND LEVEL

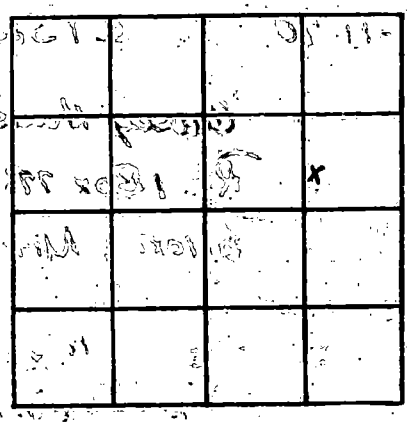

SECTION 8

Please indicate well location X.

ADDITIONAL INFORMATION

If more than one screen, show locations of each on sketch.