HARRISON
H158
9-23-71

MISSISSIPPI BOARD OF WATER COMMISSIONERS
416 North State Street
Jackson, Mississippi 39201

CODED

WATER WELL DRILLERS LOG

9-23 19 71 — date well completed
Switzer Well Co. — firm name
Harrison — county well located

LANDOWNER: Helen Mason
Rt. 1 Box 803
Biloxi, Miss. 39531
(mailing address)

WELL LOCATION:
sec. 23 T 6 S R 11 W
5 1/4 miles N of Biloxi
(distance) (direction) (nearest town)

WELL PURPOSE: Home
(home, irrigation, municipal, industrial)

WELL COMPLETION DATA:

(1) diameter (inches) 2"
(2) total depth (feet) 322'
(3) static water level (feet) 63'05" below ~~above~~ top of ground
(4) casing galv. (material), 322' (depth), ____ (size) If telescope see back.
(5) screen 20' (length), 302' (depth to top)
008 (size), Stainless Steel (material)
(6) pump 1 (HP) 12 (yield gpm)
Elect (type power)
(7) electric log No (yes or no)
✓ (organization running log)
(8) how well bottom plugged back pressure valve

DRILLERS REMARKS:

description of formations encountered	from	to
sand	0	23
sand & gravel	23	66
sand	66	87
clay	87	112
sand	112	120
clay	120	299
sand	299	322

CODED

OCT 19 1971
MISS. BD. OF WATER COMM.

If well telescopes please sketch and show depths.

GROUND LEVEL

If more than one screen, show locations of each on sketch.

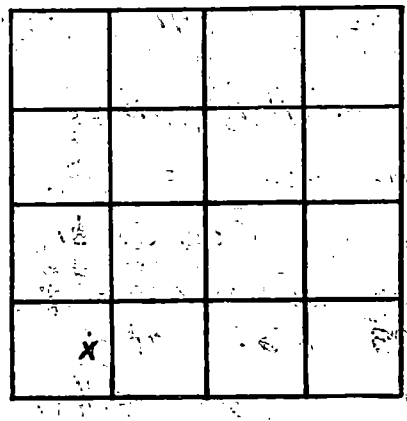

SECTION 23

Please indicate well location X.

ADDITIONAL INFORMATION