HARRISON
H 179
11-14-72

MISSISSIPPI
BOARD OF WATER COMMISSIONERS
416 North State Street
Jackson, Mississippi 39201

WATER WELL DRILLERS LOG

11-14 1972 Switzer Well Co. HARRISON
date well completed | firm name | county well located

LANDOWNER: Ashley Curington
Camp McClellan Rd.
Biloxi, Miss.
(mailing address)

WELL LOCATION:
sec. 34 T 6 S R 10 W
3 1/4 miles North of Biloxi
(distance) (direction) (nearest town)

WELL PURPOSE: Home
(home, irrigation, municipal, industrial)

WELL COMPLETION DATA:

(1) diameter (inches) 2"
(2) total depth (feet) 187'
(3) static water level (feet) 38' below above top of ground.
(4) casing galv. (material), 187' (depth),
_____ (size) if telescope see back.
(5) screen 10' (length), 177' (depth to top)
008 (size), stainless steel (material)
(6) pump 1/2 (HP) 5 (yield gpm)
electric (type power)
(7) electric log No (yes or no)
—
(organization running log)
(8) how well bottom plugged Screw
Pressure Valve

DRILLERS REMARKS: _____

description of formations encountered	from	to
clay	0	23
sand	23	28
clay	28	66
clay - sand str.	66	87
clay	87	169
sand, good	169	187

NOV 30 1972

If well telescopes please sketch and show depths.

GROUND LEVEL

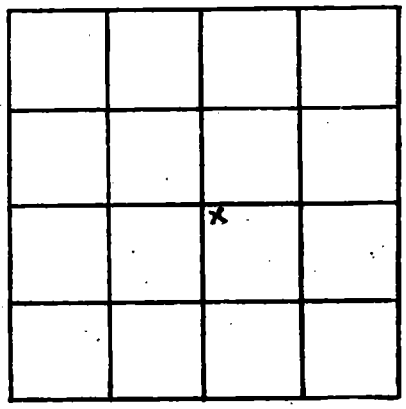

SECTION 34

Please indicate well location X.

ADDITIONAL INFORMATION

If more than one screen, show locations of each on sketch.