HARRISON
H 181
2-2-73

MISSISSIPPI
BOARD OF WATER COMMISSIONERS
416 North State Street
Jackson, Mississippi 39201

CODED

WATER WELL DRILLERS LOG

2-2 1973 R. J. Moore HARRISON
date well completed | firm name | county well located

LANDOWNER: B. GRAHAM
Biloxi River ESTATES
RT #3 Gulfport
(mailing address)

WELL LOCATION:
sec. 31 T 6 N (S) R 10 E (W)
2 1/2 miles W of WOOLMARKET
(distance) (direction) (nearest town)

WELL PURPOSE:
(home, irrigation, municipal, industrial)

WELL COMPLETION DATA:
(1) diameter (inches) 2"
(2) total depth (feet) 200'
(3) static water level (feet) 20' below above top of ground.
(4) casing PVC (material), 190' (depth),
(size) if telescope see back.
(5) screen 10' (length), 190' (depth to top)
2" (size), SS (material)
(6) pump 1 (HP) 12 (yield gpm)
E (type power)
(7) electric log (yes or no)
(organization running log)
(8) how well bottom plugged
Bw Wire

DRILLERS REMARKS:

description of formations encountered	from	to
TOP Soil	0	10
White Sand	10	16
White Clay	16	50
Sand STREAKS	50	100
Blue Clay	100	175
~~[illegible]~~		
GRAY Sand	175	200

CODED

If well telescopes please sketch and show depths.

GROUND LEVEL

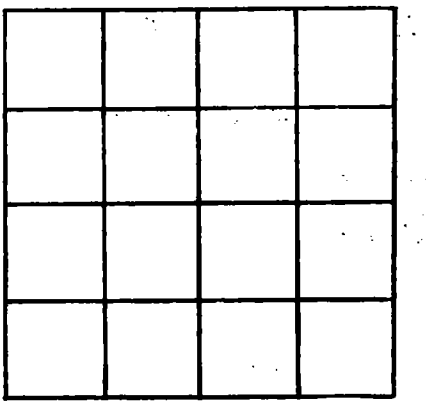

SECTION _____

Please indicate well location X.

ADDITIONAL INFORMATION

If more than one screen, show locations of each on sketch.