HARRISON
H 621
1-8-74

207

MISSISSIPPI
BOARD OF WATER COMMISSIONERS
416 North State Street
Jackson, Mississippi 39201

WATER WELL DRILLERS LOG

1-8-74 19 — R. T. Moore — HARRISON
date well completed — firm name — county well located

LANDOWNER: Levoy LADNER
Rt #3 Boles Blvd Biloxi
River Estates, Gulfport
(mailing address)

WELL LOCATION:
sec. 31 T 6 N (S) R 10 E (W)
3 1/2 miles NW of Woolmarket
(distance) (direction) (nearest town)

WELL PURPOSE:
(home, irrigation, municipal, industrial)

WELL COMPLETION DATA:
(1) diameter (inches) 2"
(2) total depth (feet) 305'
(3) static water level (feet) 30' below / above top of ground.
(4) casing PVC, 295'
(material) (depth)
(size) If telescope see back.
(5) screen 10', 295'
(length) (depth to top)
2", SS
(size) (material)
(6) pump 1 (HP) 8 (yield gpm)
E (type power)
(7) electric log (yes or no)
(organization running log)
(8) how well bottom plugged
Pea Gravel

DRILLERS REMARKS:

description of formations encountered	from	to
Top Soil	0	10
White Sand	10	30
White Clay	30	70
Blue Clay	70	280
Coarse Blue Sand	280	305

CODED

If well telescopes please sketch and show depths.

GROUND LEVEL

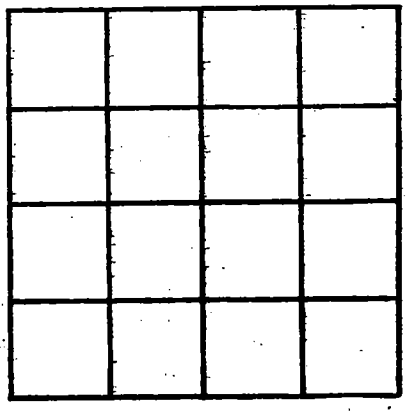

SECTION _____

Please indicate well location X.

ADDITIONAL INFORMATION

If more than one screen, show locations of each on sketch.