H 255
Harrison
8-17-84

MISSISSIPPI DEPARTMENT OF NATURAL RESOURCES

Bureau of Land and Water Resources
Southport Mall
P.O. Box 10631
Jackson, Mississippi 39209

CODED

WATER WELL DRILLERS LOG

8/17/84 19 — Lyman Well Co — Harrison
date well completed — firm name — county well located

LANDOWNER Roland Olson
Rt. 5, Box 570-M
Gulfport, Ms 39503
(mailing address)

WELL LOCATION:
sec. 31 T 6 N (S) R 10 E (W)
6 miles N of Gpt
(distance) (direction) (nearest town)

WELL PURPOSE: home
(home, irrigation, municipal, industrial)

WELL COMPLETION DATA:

(1) diameter (inches) 2"
(2) total depth (feet) 55'
(3) static water level (feet) 6' below/above top of ground.
(4) casing PVC (material), 45' (depth), 2" (size) if telescope see back.
(5) screen 10' (length), 45' (depth to top), 2" (size), PVC (material)
(6) pump NA (HP) ____ (yield gpm) ____ (type power)
(7) electric log No (yes or no) ____ No (organization running log)
(8) how well bottom plugged Sand Shack

DRILLERS REMARKS:

description of formations encountered	from	to
yellow clay	0	9
white sand	10	55

DEPT. OF NATURAL RESOURCES
BUREAU OF LAND & WATER RESOURCES
DEC 10 1984
RECEIVED

If well telescopes please sketch and show depths.

GROUND LEVEL

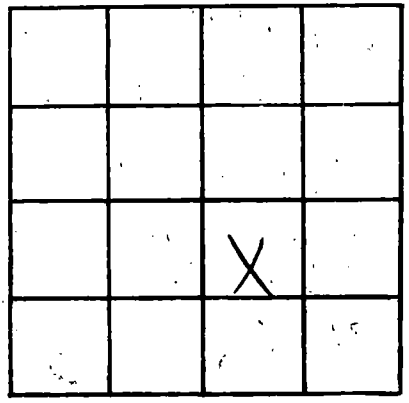

SECTION 31

Please indicate well location X.

ADDITIONAL INFORMATION

If more than one screen, show locations of each on sketch.