Harrison
H 2096
10-12-79

MISSISSIPPI
BOARD OF WATER COMMISSIONERS
416 North State Street
Jackson, Mississippi 39201

WATER WELL DRILLERS LOG

10/12 1979 — date well completed
Lyman Well — firm name
Harrison — county well located

LANDOWNER: Dobson
Rt 2 Box 301g
N. Biloxi, MS
(mailing address)

WELL LOCATION:
sec. 17 T 6 N (S) R 9 E (W)
10 (distance) miles N (direction) of Biloxi (nearest town)

WELL PURPOSE: home
(home, irrigation, municipal, industrial)

WELL COMPLETION DATA:
(1) diameter (inches) 2
(2) total depth (feet) 254
(3) static water level (feet) 30 below (above) top of ground.
(4) casing PVC (material), 244 (depth), 2 (size) If telescope see back.
(5) screen 10 (length), 244 (depth to top), 8slot (size), PVC (material)
(6) pump — (HP) — (yield gpm)
— (type power)
(7) electric log — (yes or no)
— (organization running log)
(8) how well bottom plugged Sand Shark

DRILLERS REMARKS:

description of formations encountered	from	to
White sand	0	60
gray & blue clay	60	240
sand	240	254

DEPT. OF NATURAL RESOURCES
BUREAU OF LAND & WATER RESOURCES
JAN 7 1980
RECEIVED

If well telescopes please sketch and show depths.

GROUND LEVEL

If more than one screen, show locations of each on sketch.

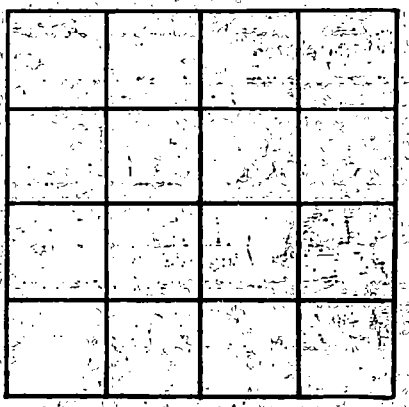

SECTION

Please indicate well location X.

ADDITIONAL INFORMATION