HARRISON
H 2152
9-29-81

MISSISSIPPI DEPARTMENT OF NATURAL RESOURCES

Bureau of Land and Water Resources
Southport Mall
P.O. Box 10631
Jackson, Mississippi 39209

WATER WELL DRILLERS LOG

9/29/81 19 Lyman Well Co. Harrison
date well completed — firm name — county well located

LANDOWNER: Mr Bernard Talley
Hwy 67 Biloxi
Miss.
(mailing address)

WELL LOCATION:
sec. 8 T 6 N (S) R 10 E (W)
7 miles W/E of Wool Market
(distance) (direction) (nearest town)

WELL PURPOSE: Home
(home, irrigation, municipal, industrial)

WELL COMPLETION DATA:
(1) diameter (inches) 4x2
(2) total depth (feet) 484
(3) static water level (feet) 88 below ~~above~~ top of ground.
(4) casing PVC (material), 464 (depth), 4x2 (size) If telescope see back.
(5) screen 20 (length), 464 (depth to top), 2 (size), PVC (material)
(6) pump 1½ (HP), 25 (yield gpm), Electric (type power)
(7) electric log No (yes or no)
No (organization running log)
(8) how well bottom plugged sand seal

DRILLERS REMARKS:

description of formations encountered	from	to
Red Clay Sand Gravel	0	100
Gray Clay Some fine Sand	100	230
Fair Sand	230	270
Blue Clay	270	360
Blue Clay fine Sand	360	394
~~394~~	~~448~~	
Fair Sand	394	448
Good Sand	448	484

DEPT. OF NATURAL RESOURCES
BUREAU OF LAND & WATER RESOURCES
OCT 30 1981
RECEIVED

If well telescopes please sketch and show depths.

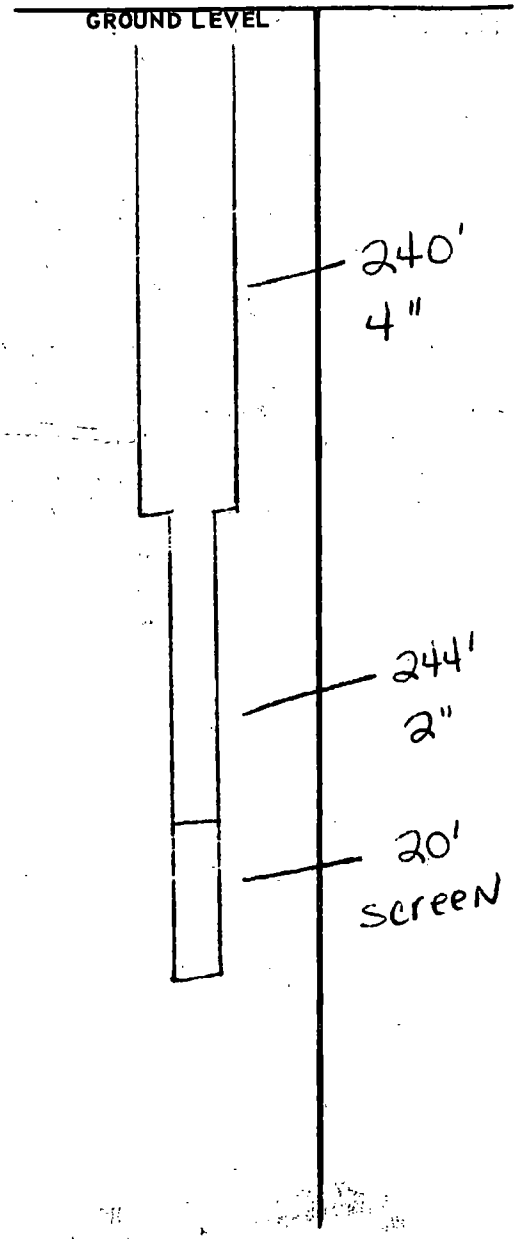

If more than one screen, show locations of each on sketch.

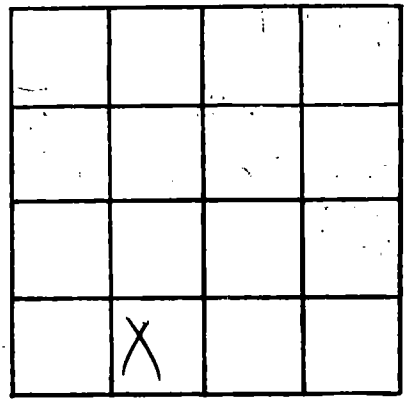

SECTION 8

Please indicate well location X.

ADDITIONAL INFORMATION