Harrison
H 2296
2-19-85

MISSISSIPPI DEPARTMENT OF NATURAL RESOURCES

Bureau of Land and Water Resources
Southport Mall
P.O. Box 10631
Jackson, Mississippi 39209

WATER WELL DRILLERS LOG

COASTAL DRILLING & SERVICE CO.
RT. 11, BOX 81
Gulfport, MS 39502

2/19/85 — date well completed
19 — firm name
Harrison — county well located

LANDOWNER: Jimmy Williams
Rt. 4 Box 25
Biloxi, MS
(mailing address)

WELL LOCATION:
sec. 3 T 6 S R 10 W
Woolmarket (distance) miles (direction) of (nearest town)

WELL PURPOSE: home
(home, irrigation, municipal, industrial)

WELL COMPLETION DATA:

(1) diameter (inches) 2"
(2) total depth (feet) 280
(3) static water level (feet) 10 below ~~above~~ top of ground.
(4) casing PVC (material), 270 (depth),
(size) If telescope see back.
(5) screen 10 (length), 270 (depth to top)
2" (size), PVC (material)
(6) pump 1 (HP) 8 (yield gpm)
E/C (type power)
(7) electric log No (yes or no)
(organization running log)
(8) how well bottom plugged 2" back wash valve 19-B

DRILLERS REMARKS:

description of formations encountered	from	to
top soil	1	5
sugar sand	5	20
red clay	20	140
hard blue clay	140	260
fine water sand	260	270
good water sand	270	280

RECEIVED
JUL 25 1985
Department of Natural Resources
Bureau of Land & Water Resources

If well telescopes please sketch and show depths.

GROUND LEVEL

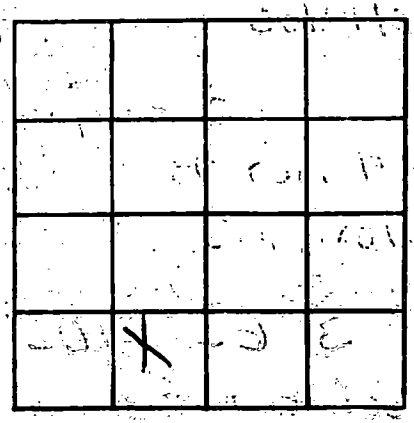

SECTION _____

Please indicate well location X.

ADDITIONAL INFORMATION

If more than one screen, show locations of each on sketch.