MISSISSIPPI DEPARTMENT OF NATURAL RESOURCES

Bureau of Land and Water Resources

P.O. Box 10631
Jackson, Mississippi 39209

WATER WELL DRILLERS LOG

COUNTY WELL LOCATED	HARRISON
WELL NUMBER	H 24
CODED	31
DATE WELL COMPLETED	3-13-87
PERMIT NUMBER	
NAME OF DRILLING FIRM	BRADEN Pump + Well
	17170 COUNTRY COVE SAUCIER, MS 39574

NAME & MAILING ADDRESS OF LANDOWNER
JERRY BERHOW
Rt. 2 Box 305-D
Biloxi, Ms. 39532-9539

WELL LOCATION: SEC 29 TOWNSHIP 6 S RANGE 9 W

DISTANCE 3 Miles DIRECTION N of NEAREST TOWN Saucier

OTHER LANDMARK

WELL PURPOSE: Home, Irrigation, Municipal, Industrial, Fish Pond, etc.
Home

PUMP DATA

PUMP TYPE (Circle One): Submersible, Turbine, Jet, Flowing Well, Other (Describe)

POWER TYPE (Circle One): Electric, Tractor, Diesel, Gasoline, Butane, Other (Describe)

Pump Capacity (GPM)	No. of Stages	Setting Depth
25		100 FT.

PUMP TEST

Well yielded 20 GPM with a drawdown of _____ ft. after _____ hours of pumping

WELL DATA

Well Depth	Casing Diameter (In.)	Casing Length (Ft.)
310	4" X 2"	290
Type of Casing	**Hole Depth**	**Depth to Static Water Level**
PVC	310	38

TYPE OF COMPLETION: (Circle One or More): Gravel Packed, Underreamed, Telescoped, Natural Development, Open Hole, Other (Describe)

Top of Lap Pipe or Reduction in Casing FEET

IF TELESCOPED OR MORE THAN ONE SCREEN: USE BACK PAGE

SCREEN DATA

Diameter - Inches	Length - Feet	Slot Size - Inches
2	10	.008
Screen Type		**Depth to Bottom - Feet**
PVC Wrapped		300

LOG DATA

TYPE OF LOG RUN (Circle One): No Log Run, Electric, Gamma Ray, Density, Sonic, Neutron, Other (Describe)

Name of Organization Running Log

GEOLOGIC DATA (Office Use Only)

Surface Elev.	Geologic Unit	Unit Thickness	Depth to Top
Subs. SWL	Date	Analysis	Aquifer Test

Driller's Remarks

DESCRIPTION OF FORMATIONS ENCOUNTERED	FROM	TO
Surface	0	4
Brown Clay	4	20
White Clay	20	80
Blue Clay	80	205
Sand & Clay Breaks	205	220
Medium Grey Sand	220	304
Blue Clay	304	310

FORMATIONS (Continued) FROM TO

IF MORE SPACE IS NEEDED, USE BACK

RECEIVED
MAR 30 1987
Department of Natural Resources
Bureau of Land & Water Resources

If well telescopes please
sketch and show depths.

GROUND LEVEL

4" pvc

200FT

2" PVC

290FT

300FT

310FT

2"x10FT pvc Screen

2" pvc Toilpipe

3" pvc Sand Shark

If more than one screen,
show location of each on sketch.

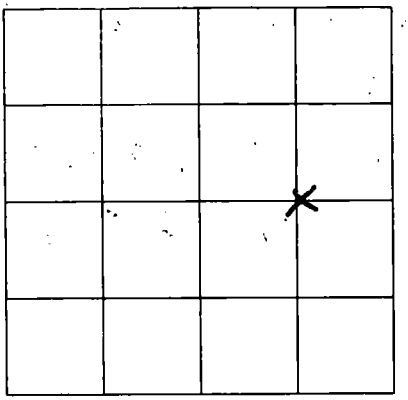

SECTION 29

Please indicate well location X.

ADDITIONAL INFORMATION