Harrison
H
0239
2456

MISSISSIPPI DEPARTMENT OF NATURAL RESOURCES

Bureau of Land and Water Resources
Southport Mall
P.O. Box 10631
Jackson, Mississippi 39209

WATER WELL DRILLERS LOG

December 12 1987 McGill Pump & Well Harrison
date well completed — firm name — county well located

LANDOWNER: Frank Taylor
10470 Walmart rd.
Biloxi Ms. 39532
(mailing address)

WELL LOCATION:
sec. 2 T 6 (N) (S) R 10 (E) (W)
1 miles North of Walmart
(distance) (direction) (nearest town)

WELL PURPOSE:
(home) irrigation, municipal, industrial)

WELL COMPLETION DATA:

(1) diameter (inches) 4"X2"

(2) total depth (feet) 240'

(3) static water level (feet) 40' (below) above top of ground.

(4) casing PVC (material), 220 (depth),
4"X2" (size) if telescope see back.

(5) screen 20' (length), 240 (depth to top)
2" (size), PVC (material)

(6) pump Used (HP) Own Pump (yield gpm)

(type power)

(7) electric log (yes or (no))

(organization running log)

(8) how well bottom plugged Seal

DRILLERS REMARKS:

description of formations encountered	from	to
mud	0	20
Sand	20	50
mud	50	200
Sand	200	240

RECEIVED
JAN 27 1988
Department of Natural Resources
Bureau of Land & Water Resources

If well telescopes please sketch and show depths.

GROUND LEVEL

120' = 4"

120' = 2"

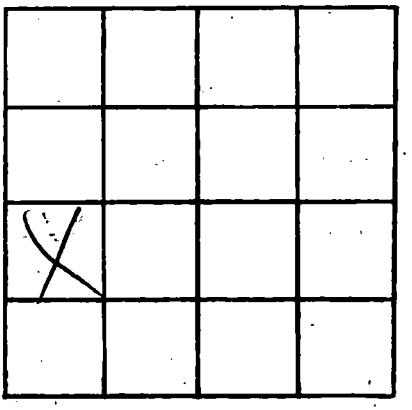

SECTION _____

Please indicate well location X.

ADDITIONAL INFORMATION

If more than one screen, show locations of each on sketch.