MISSISSIPPI DEPARTMENT OF NATURAL RESOURCES

Bureau of Land and Water Resources

P.O. Box 10631
Jackson, Mississippi 39209

WATER WELL DRILLERS LOG

COUNTY WELL LOCATED: Harrison	
WELL NUMBER: H 2464	CODED
DATE WELL COMPLETED: April 25-1988	
PERMIT NUMBER: 0739	
NAME OF DRILLING FIRM: McGill Pump + Wells	

NAME & MAILING ADDRESS OF LANDOWNER
Mike McFaddin
Biloxi River Est.

WELL LOCATION: SEC 31 TOWNSHIP 6 N (S) RANGE 10 E (W)

DISTANCE 6 Miles DIRECTION East of NEAREST TOWN Kpt

OTHER LANDMARK

WELL PURPOSE: Home, Irrigation, Municipal, Industrial, Fish Pond, etc.

PUMP DATA

PUMP TYPE (Circle One): Submersible, Turbine, Jet, Flowing Well, Other (Describe) ____

POWER TYPE (Circle One): Electric, Tractor, Diesel, Gasoline, Butane, Other (Describe) ____

Pump Capacity (GPM)	No. of Stages	Setting Depth
13	2	20' FT.

PUMP TEST

Well yielded 13 GPM with a drawdown of 10 ft. after 1 hours of pumping

WELL DATA

Well Depth	Casing Diameter (In.)	Casing Length (Ft.)
40'	2"	30'

Type of Casing	Hole Depth	Depth to Static Water Level
PVC	40	5'

TYPE OF COMPLETION: (Circle One or More): Gravel Packed, Underreamed, Telescoped, Natural Development, Open Hole, Other (Describe) ____

Top of Lap Pipe or Reduction in Casing FEET

IF TELESCOPED OR MORE THAN ONE SCREEN: USE BACK PAGE

LOG DATA

TYPE OF LOG RUN (Circle One): No Log Run, Electric, Gamma Ray, Density, Sonic, Neutron, Other (Describe) ____

Name of Organization Running Log

GEOLOGIC DATA (Office Use Only)

Surface Elev.	Geologic Unit	Unit Thickness	Depth to Top
Subs. SWL	Date	Analysis	Aquifer Test

Driller's Remarks
Well not for drinking

SCREEN DATA

Diameter - Inches	Length - Feet	Slot Size - Inches
2"	10'	.0006

Screen Type	Depth to Bottom - Feet
PVC	40'

DESCRIPTION OF FORMATIONS ENCOUNTERED	FROM	TO
mud	0	10
Sand	10	40

FORMATIONS (Continued) FROM TO

IF MORE SPACE IS NEEDED, USE BACK

RECEIVED
JUN 17 1988
Department of Natural Resources
Bureau of Land & Water Resources

If well telescopes please
sketch and show depths.

GROUND LEVEL

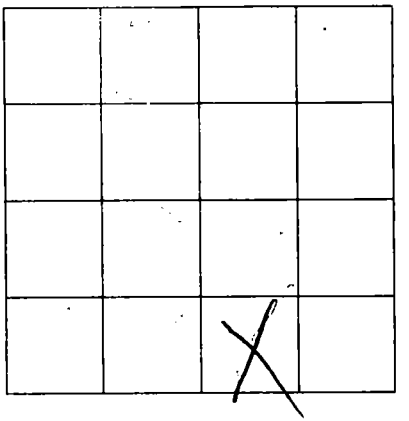

SECTION _____

Please indicate well location X.

ADDITIONAL INFORMATION

If more than one screen,
show location of each on sketch.