MISSISSIPPI DEPARTMENT OF NATURAL RESOURCES

Bureau of Land and Water Resources

P.O. Box 10631
Jackson, Mississippi 39209

WATER WELL DRILLERS LOG

COUNTY WELL LOCATED: Harrison	
WELL NUMBER: H 2469	CODED:
DATE WELL COMPLETED: 2-24-89	
PERMIT NUMBER:	
NAME OF DRILLING FIRM: Moo B Drilling Co.	
Braden Pumps Well Dr.	

NAME & MAILING ADDRESS OF LANDOWNER
Stafford Aolancy
11062 Lee Rd
Biloxi, Miss. 39532

WELL LOCATION: SEC 19 TOWNSHIP S RANGE 10 W

DISTANCE 2½ Miles DIRECTION NW of NEAREST TOWN Woolmarket

OTHER LANDMARK

WELL PURPOSE: Home, Irrigation, Municipal, Industrial, Fish Pond, etc.
Home

PUMP DATA

PUMP TYPE (Circle One): Submersible, Turbine, (Jet) Flowing Well, Other (Describe) _____

POWER TYPE (Circle One): (Electric) Tractor, Diesel, Gasoline, Butane, Other (Describe) _____ H/P _____

Pump Capacity (GPM)	No. of Stages	Setting Depth
8	2	80 FT.

PUMP TEST

Well yielded 8 GPM with a drawdown of _____ ft. after _____ hours of pumping

WELL DATA

Well Depth	Casing Diameter (In.)	Casing Length (Ft.)
420	2"	400

Type of Casing	Hole Depth	Depth to Static Water Level
PVC	420	55

TYPE OF COMPLETION: (Circle One or More): Gravel Packed, Underreamed, Telescoped, (Natural Development) Open Hole, Other (Describe) _____

Top of Lap Pipe or Reduction in Casing FEET

IF TELESCOPED OR MORE THAN ONE SCREEN: USE BACK PAGE

LOG DATA

TYPE OF LOG RUN (Circle One): (No Log Run) Electric, Gamma Ray, Density, Sonic, Neutron, Other (Describe) _____

Name of Organization Running Log

GEOLOGIC DATA (Office Use Only)

Surface Elev.	Geologic Unit	Unit Thickness	Depth to Top
Subs. SWL	Date	Analysis	Aquifer Test

Driller's Remarks

10FT Tailpipe

SCREEN DATA

Diameter - Inches	Length - Feet	Slot Size - Inches
2	10	.008

Screen Type	Depth to Bottom - Feet
PVC WOP	410

DESCRIPTION OF FORMATIONS ENCOUNTERED	FROM	TO
Sand & Clay	0	20
Red Clay	20	40
Red & Brown Sand	40	90
Gravel	90	100
Blue Clay	100	320
Gray Sand	320	420 +

FORMATIONS (Continued)	FROM	TO

RECEIVED
APR 21 1989
Dept. of Natural Resources
Bureau of Land & Water Resources

IF MORE SPACE IS NEEDED, USE BACK

If well telescopes please
sketch and show depths.

GROUND LEVEL

If more than one screen,
show location of each on sketch.

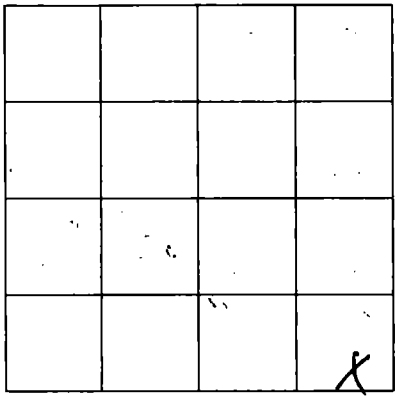

SECTION 19

Please indicate well location X.

ADDITIONAL INFORMATION