MISSISSIPPI DEPARTMENT OF ENVIRONMENTAL QUALITY
Bureau of Land and Water Resources

P. O. Box 10631
Jackson, MS 39289-0631
WATER WELL DRILLERS LOG

COUNTY WELL LOCATED	Harrison
WELL NUMBER	H2504
CODED	
DATE WELL COMPLETED	11-14-88
PERMIT NUMBER	
NAME OF DRILLER	Coastal Drilling & Service Co.
	8456 Woolmarket Biloxi Road
	Biloxi, Mississippi 39532

NAME & MAILING ADDRESS OF LANDOWNER
Karen Desport
2381 Old Woolmarket Rd
Biloxi, Ms. 39532

WELL LOCATION: SEC TOWNSHIP RANGE N (S) E (W)
Harrison 29 6 10

DISTANCE DIRECTION NEAREST TOWN
1½ Miles NW of Woolmarket

OTHER LANDMARK
Ms. Power line

WELL PURPOSE: (Home) Irrigation, Municipal, Industrial, Fish Pond, etc.
Home

PUMP DATA

PUMP TYPE (Circle One): Submersible, Turbine, (Jet) Flowing Well, Other (Describe) _____

POWER TYPE (Circle One): (Electric) Tractor, Diesel, Gasoline, Butane, Other (Describe) _____ H/P _____

Pump Capacity (GPM)	No. of Stages	Setting Depth
10	2	60 FT.

PUMP TEST

Well yielded 10 GPM with a drawdown of 0 ft. after 5 hours of pumping

WELL DATA

Well Depth	Casing Diameter (In.)	Casing Length (Ft.)
300'	2"	290'

Type of Casing	Hole Depth	Depth to Static Water Level
PVC	300	45'

TYPE OF COMPLETION: (Circle One or More): Gravel Packed, Underreamed, Telescoped, (Natural Development), Open Hole, Other (Describe) _____

Top of Lap Pipe or Reduction in Casing FEET

IF TELESCOPED OR MORE THAN ONE SCREEN: USE BACK PAGE

LOG DATA

TYPE OF LOG RUN (Circle One): No Log Run, Electric, Gamma Ray, Density, Sonic, Neutron, Other (Describe) _____

Name of Organization Running Log

GEOLOGIC DATA (Office Use Only)

Surface Elev.	Geologic Unit	Unit Thickness	Depth to Top
Subs. SWL	Date	Analysis	Aquifer Test

Driller's Remarks
None

SCREEN DATA

Diameter - Inches	Length - Feet	Slot Size - Inches
2"	10'	.008

Screen Type	Depth to Bottom - Feet
PVC	300'

DESCRIPTION OF FORMATIONS ENCOUNTERED	FROM	TO
top soil	1'	3'
Red sand	3'	12'
White sand	12'	20'
soft Blue clay	20'	85'
Hard Blue clay	85'	260'
fine watery sand	260'	280'
Coarse water sand	280'	300

FORMATIONS ENCOUNTERED	FROM	TO

IF MORE SPACE IS NEEDED, USE BACK

RECEIVED
FEB 18 1992
Dept. of Environmental Quality
Bureau of Land & Water Resources

If well telescopes please sketch and show depths.

GROUND LEVEL

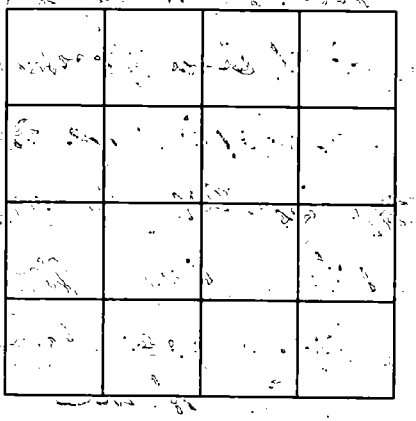

SECTION _____

Please indicate well location X.

ADDITIONAL INFORMATION

If more than one screen, show location of each on sketch.