MISSISSIPPI DEPARTMENT OF ENVIRONMENTAL QUALITY
Bureau of Land and Water Resources

P. O. Box 10631
Jackson, MS 39289-0631

WATER WELL DRILLERS LOG

COUNTY WELL LOCATED: Harrison	
WELL NUMBER: 4	CODED:
2527	
DATE WELL COMPLETED: 12-21-91	

PERMIT NUMBER	
NAME OF DRILLING FIRM: [illegible]	

NAME & MAILING ADDRESS OF LANDOWNER: [illegible] Hilliard, Lamey Bridge Rd., Biloxi, Ms.

WELL LOCATION: SEC 14 TOWNSHIP 6 ~~N~~ S RANGE 10 ~~E~~ W

DISTANCE 7 Miles DIRECTION N of NEAREST TOWN Biloxi

OTHER LANDMARK

WELL PURPOSE: Home, Irrigation, Municipal, Industrial, Fish Pond, etc.

PUMP DATA

PUMP TYPE (Circle One): Submersible, Turbine, Jet, Flowing Well, Other (Describe) _____

POWER TYPE (Circle One): Electric, Tractor, Diesel, Gasoline, Butane, Other (Describe) _____ H/P _____

Pump Capacity (GPM)	No. of Stages	Setting Depth
4	3	160 Jet FT.

PUMP TEST

Well yielded _____ GPM with a drawdown of _____ ft. after _____ hours of pumping

WELL DATA

Well Depth	Casing Diameter (In.)	Casing Length (Ft.)
280'	2"	270'

Type of Casing	Hole Depth	Depth to Static Water Level
PVC	280'	140'

TYPE OF COMPLETION: (Circle One or More): Gravel Packed, Underreamed, Telescoped, Natural Development, Open Hole, Other (Describe) _____

Top of Lap Pipe or Reduction in Casing FEET

IF TELESCOPED OR MORE THAN ONE SCREEN: USE BACK PAGE

LOG DATA

TYPE OF LOG RUN (Circle One): Electric, Gamma Ray, Density, Sonic, Neutron, No Log Run, Other (Describe) _____

Name of Organization Running Log

GEOLOGIC DATA (Office Use Only)

Surface Elev.	Conductivity	Drill Pipe Pressure	Depth to Top
Subs. SWL	Date	Analysis	Aquifer Test

Driller's Remarks

RECEIVED JAN 06 1992 Dept. of Environmental Quality Bureau of Land & Water Resources

SCREEN DATA

Diameter - Inches	Length - Feet	Slot Size - Inches
2"	10'	.018

Screen Type	Depth to Bottom - Feet
PVC	280'

DESCRIPTION OF FORMATIONS ENCOUNTERED	FROM	TO	FORMATIONS (Continued)	FROM	TO
[illegible]	1	2			
[illegible]	2	[illegible]			
[illegible]	[illegible]	[illegible]			
[illegible]	50	10			
[illegible]	210	[illegible]			
[illegible]	210	[illegible]			
[illegible]	250	[illegible]			
			IF MORE SPACE IS NEEDED, USE BACK		

If well telescopes please sketch and show depths.

GROUND LEVEL

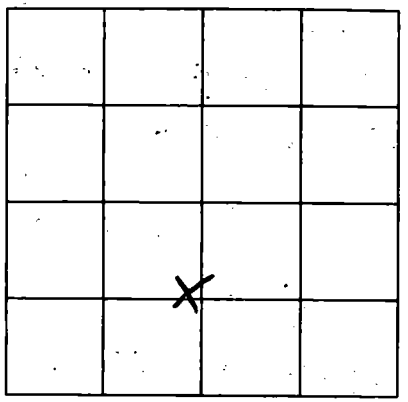

SECTION 14

Please indicate well location X.

ADDITIONAL INFORMATION

RECEIVED
JAN 05 1995
Dept. of Environmental Quality
Bureau of Land & Water Resources

If more than one screen, show location of each on sketch.