MISSISSIPPI DEPARTMENT OF ENVIRONMENTAL QUALITY
Office of Land and Water Resources

P. O. Box 10631
Jackson, MS 39289-0631
WATER WELL DRILLERS LOG

COUNTY WELL LOCATED: Harrison	
WELL NUMBER: H 2167 618	CODED:
DATE WELL COMPLETED: 11-11-95	
PERMIT NUMBER: 0239	
NAME OF DRILLING FIRM: McGill Pump & Well	

NAME & MAILING ADDRESS OF LANDOWNER: Billy Businelle, Lot 41 Sweet Carolyn, Woolmarket rd.

WELL LOCATION. SEC	TOWNSHIP	RANGE
28	6 N (S)	10 E (W)

DISTANCE	DIRECTION	NEAREST TOWN
4 Miles	North of	Woolmarket

OTHER LANDMARK:

WELL PURPOSE: (Home) Irrigation, Municipal, Industrial, Fish Pond, etc.

PUMP DATA

PUMP TYPE (Circle One): Submersible, Turbine, (Jet) Flowing Well, Other (Describe) ____

POWER TYPE (Circle One): (Electric) Tractor, Diesel, Gasoline, Butane, Other (Describe) ____ H/P 1

Pump Capacity (GPM)	No. of Stages	Setting Depth
10	2	100' FT.

PUMP TEST

Well yielded 10 GPM with a drawdown of 10 ft. after 12 hours of pumping

WELL DATA

Well Depth	Casing Diameter (In.)	Casing Length (Ft.)
400'	2"	380'

Type of Casing	Hole Depth	Depth to Static Water Level
PVC	400'	80'

TYPE OF COMPLETION: (Circle One or More): Gravel Packed, Underreamed, Telescoped, (Natural Development), Open Hole, Other (Describe) ____

WELL GROUTED TO A DEPTH OF 10 FEET
Type Grout (circle one): Cement, Bentonite, or Mix

LOG DATA

TYPE OF LOG RUN (Circle One): (No Log Run) Electric, Gamma Ray, Density, Sonic, Neutron, Other (Describe) ____

Name of Organization Running Log:

GEOLOGIC DATA (Office Use Only)

Surface Elev.	Geologic Unit	Unit Thickness	Depth to Top
Subs. SWL	Date	Analysis	Aquifer Test

Driller's Remarks:

SCREEN DATA

Diameter - Inches	Length - Feet	Slot Size - Inches
2"	20'	.0006

Screen Type	Depth to Bottom - Feet
PVC	400'

Top of Lap Pipe or Reduction in Casing: FEET

IF TELESCOPED OR MORE THAN ONE SCREEN: USE BACK PAGE

DESCRIPTION OF FORMATIONS ENCOUNTERED	FROM	TO	FORMATIONS (Continued)	FROM	TO
mud	0	140			
sand	140	160			
mud	160	360			
sand	360	400			
			IF MORE SPACE IS NEEDED, USE BACK		

RECEIVED
JUN 30 1997
Dept. of Environmental Quality
Off. of Land & Water Resources

If well telescopes please
sketch and show depths.

GROUND LEVEL

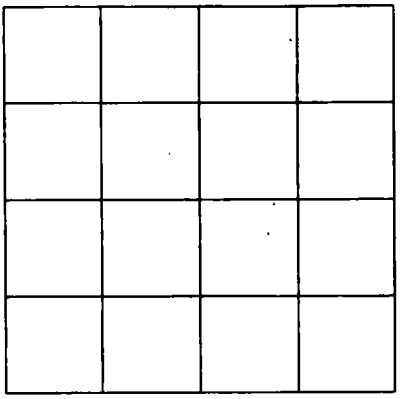

SECTION _____

Please indicate well location X.

ADDITIONAL INFORMATION

If more than one screen,
show location of each on sketch.