MISSISSIPPI DEPARTMENT OF ENVIRONMENTAL QUALITY
Office of Land and Water Resources

P. O. Box 10631
Jackson, MS 39289-0631

WATER WELL DRILLERS LOG

COUNTY WELL LOCATED: ~~Jackson~~ Harrison	
WELL NUMBER: 23	CODED
H 2671	
DATE WELL COMPLETED: 11/17/99	

PERMIT NUMBER: 0-493	
NAME OF DRILLING FIRM: BEECH'S WELL WORKS	

NAME & MAILING ADDRESS OF LANDOWNER
Willie Davis
Feller Drive Lot# 16
Biloxi Ms 39530

WELL LOCATION: SEC 36 TOWNSHIP 6 N (S) RANGE 10 E (W)

DISTANCE _____ Miles DIRECTION _____ of NEAREST TOWN _____

OTHER LANDMARK

WELL PURPOSE: Home, Irrigation, Municipal, Industrial, Fish Pond, etc.

PUMP DATA

PUMP TYPE (Circle One): Submersible, Turbine, (Jet) Flowing Well, Other (Describe) _____

POWER TYPE (Circle One): (Electric.) Tractor, Diesel, Gasoline, Butane, Other (Describe) _____ H/P _____

Pump Capacity (GPM)	No of Stages	Setting Depth
13	2	60 FT.

PUMP TEST

Well yielded _____ GPM with a drawdown of _____ ft. after _____ hours of pumping

WELL DATA

Well Depth	Casing Diameter (In.)	Casing Length (Ft.)
267	2"	247
Type of Casing	**Hole Depth**	**Depth to Static Water Level**
PVC	267	31 ft.

TYPE OF COMPLETION: (Circle One or More): Gravel Packed, Underreamed, Telescoped, (Natural Development.) Open Hole, Other (Describe) _____

WELL GROUTED TO A DEPTH OF 10 FEET
Type Grout (circle one): (Cement) Bentonite, or Mix

LOG DATA

TYPE OF LOG RUN (Circle One): (No Log Run) Electric, Gamma Ray, Density, Sonic, Neutron, Other (Describe) _____

Name of Organization Running Log

GEOLOGIC DATA (Office Use Only)

Surface Elev	Geologic Unit	Unit Thickness	Depth to Top
Subs. SWL	Date	Analysis	Aquifer Test

Driller's Remarks

Top of Lap Pipe or Reduction in Casing _____ FEET

IF TELESCOPED OR MORE THAN ONE SCREEN: USE BACK PAGE

SCREEN DATA

Diameter - Inches	Length - Feet	Slot Size - Inches
2	20	.006
Screen Type		**Depth to Bottom - Feet**
PVC		

DESCRIPTION OF FORMATIONS ENCOUNTERED	FROM	TO	FORMATIONS (Continued)	FROM	TO
Clay	0	19			
Sand	19	124			
Blue Clay	124	234			
green sand	234	267			
			IF MORE SPACE IS NEEDED, USE BACK		

RECD MAY 08 2001

If well telescopes please sketch and show depths.

GROUND LEVEL

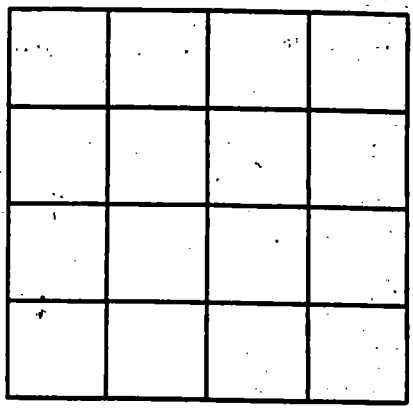

SECTION _____

Please indicate well location X.

ADDITIONAL INFORMATION

If more than one screen,