MISSISSIPPI DEPARTMENT OF ENVIRONMENTAL QUALITY
Office of Land and Water Resources

P. O. Box 10631
Jackson, MS 39289-0631
WATER WELL DRILLERS LOG

COUNTY WELL LOCATED: Harrison
WELL NUMBER: H-2672 | CODED:
DATE WELL COMPLETED: 6/07/01
PERMIT NUMBER: 0-234
NAME OF DRILLING FIRM: mcgill pump + well

NAME & MAILING ADDRESS OF LANDOWNER
Kenie mc Gill
23890 michal
Gulfport, ms 39503

WELL LOCATION — SEC: 34 TOWNSHIP: 6 N/S RANGE: 10 E/W
DISTANCE: ____ Miles DIRECTION: ____ of NEAREST TOWN: ____
OTHER LANDMARK:
WELL PURPOSE: (Home) Irrigation, Municipal, Industrial, Fish Pond, etc.

PUMP DATA

PUMP TYPE (Circle One): Submersible, Turbine, Jet, Flowing Well, Other (Describe) ____
POWER TYPE (Circle One): Electric, Tractor, Diesel, Gasoline, Butane, Other (Describe) ____ H/P ____

Pump Capacity (GPM)	No. of Stages	Setting Depth
		FT.

PUMP TEST
Well yielded ____ GPM with a drawdown of ____ ft. after ____ hours of pumping

WELL DATA

Well Depth	Casing Diameter (In.)	Casing Length (Ft.)
380	2	360

Type of Casing	Hole Depth	Depth to Static Water Level
PVC	380	60

TYPE OF COMPLETION: (Circle One or More): Gravel Packed, Underreamed, Telescoped, Natural Development, Open Hole, Other (Describe) ____

WELL GROUTED TO A DEPTH OF 10 FEET
Type Grout (circle one): Cement, Bentonite, or Mix

LOG DATA

TYPE OF LOG RUN (Circle One): No Log Run, Electric, Gamma Ray, Density, Sonic, Neutron, Other (Describe) ____
Name of Organization Running Log:

GEOLOGIC DATA (Office Use Only)

Surface Elev.	Geologic Unit	Unit Thickness	Depth to Top
Subs. SWL	Date	Analysis	Aquifer Test

Driller's Remarks:

Top of Lap Pipe or Reduction in Casing: ____ FEET
IF TELESCOPED OR MORE THAN ONE SCREEN: USE BACK PAGE

SCREEN DATA

Diameter - Inches	Length - Feet	Slot Size - Inches
2"	20	.006

Screen Type	Depth to Bottom - Feet
PVC	380

DESCRIPTION OF FORMATIONS ENCOUNTERED	FROM	TO
Sand	0	140
mud	140	260
sand	260	300
mud	300	320
Sand	320	380

FORMATIONS (Continued)	FROM	TO
RECD JUN 25 2001		

IF MORE SPACE IS NEEDED, USE BACK

If well telescopes please sketch and show depths.

GROUND LEVEL

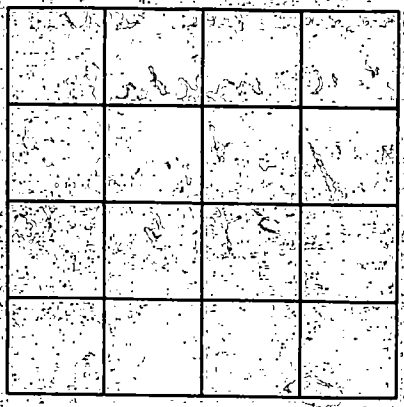

SECTION

Please indicate well location X

ADDITIONAL INFORMATION

If more than one screen, show location of each on sketch.