HARRISON
J 136
10-1-71

MISSISSIPPI
BOARD OF WATER COMMISSIONERS
416 North State Street
Jackson, Mississippi 39201

WATER WELL DRILLERS LOG

CODED

Oct. 1 19 71 — date well completed
Sutter Well Works — firm name
Harrison — county well located

LANDOWNER: Mrs. Jos. Butler
De Lisle, Miss.
(mailing address)

WELL LOCATION:
sec. 8 T 7 S R 13 W
(distance) miles in (direction) of De Lisle (nearest town)

WELL PURPOSE: home
(home, irrigation, municipal, industrial)

WELL COMPLETION DATA:

(1) diameter (inches) 2"
(2) total depth (feet) 771'
(3) static water level (feet) 15' ~~below~~ above top of ground.
(4) casing galv. (material), 756' (depth), 2" (size) if telescope see back.
(5) screen 15' (length), 756' (depth to top), 2" (size), stainless steel (material)
(6) pump none (HP) (yield gpm)
(type power)
(7) electric log no (yes or no)
(organization running log)
(8) how well bottom plugged B.P.Valve

DRILLERS REMARKS:

description of formations encountered	from	to
Clay	0	8
Sand	8	57
Clay	57	180
Clay-sand streaks	180	410
Sand	410	433
Clay	433	490
Sand	490	570
Clay	570	615
Sand	615	787
Clay	787	829

CODED

NOV 3 - 1971

MISS. [illegible]
[illegible]

If well telescopes please sketch and show depths.

GROUND LEVEL

If more than one screen, show locations of each on sketch.

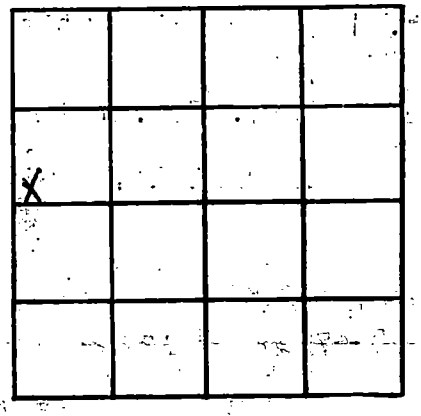

SECTION 8

Please indicate well location X.

ADDITIONAL INFORMATION