HARRISON
J 145
6-21-72

MISSISSIPPI
BOARD OF WATER COMMISSIONERS
416 North State Street
Jackson, Mississippi 39201

CODED

WATER WELL DRILLERS LOG

June 21 19 72 — date well completed
Sutter Well Works — firm name
Harrison — county well located

LANDOWNER: Lee Sprinkle
West North Street
PassChristian, Miss.
(mailing address)

WELL LOCATION:
sec. 34 T. 7 ~~N~~ S R. 13 ~~E~~ W
1 (distance) miles N (direction) of DeLisle (nearest town)

WELL PURPOSE: home
(home, irrigation, municipal, industrial)

WELL COMPLETION DATA:
(1) diameter (inches) 2"
(2) total depth (feet) 545'
(3) static water level (feet) 32' below above top of ground.
(4) casing galv. (material), 530' (depth), 2" (size) If telescope see back.
(5) screen 15' (length), 530' (depth to top), 2" (size), stainless steel (material)
(6) pump owner's (HP) (yield gpm)
(type power)
(7) electric log no (yes or no)
(organization running log)
(8) how well bottom plugged B.P.Valve

DRILLERS REMARKS:

description of formations encountered	from	to
Clay	0	12
Sand & gravel	12	111
Clay, sand streaks	111	400
Sand	400	415
Clay	415	508
Sand	508	545

CODED

JUL 24 1972

If well telescopes please sketch and show depths.

GROUND LEVEL

If more than one screen, show locations of each on sketch.

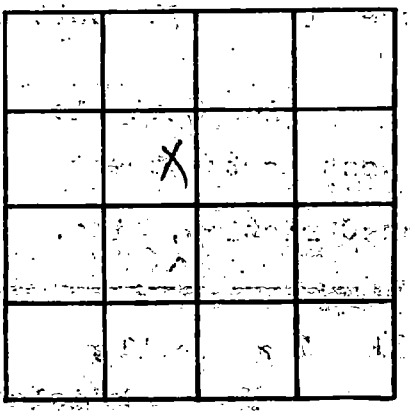

SECTION _____

Please indicate well location X.

ADDITIONAL INFORMATION