HARRISON
J
3-24-78
2038

MISSISSIPPI
BOARD OF WATER COMMISSIONERS
416 North State Street
Jackson, Mississippi 39201

WATER WELL DRILLERS LOG

3-24- 1978 — date well completed
McKee Well Works, Inc. — firm name
Harrison — county well located

LANDOWNER: Douglas Fadner
Rt. 2, Box 302
P.C., Ms.
(mailing address)

WELL LOCATION:
sec. 7 T. 7 N (S) R. 13 E (W)
4 (distance) miles 5 (direction) of Vancleave (nearest town)

WELL PURPOSE: (home, irrigation, municipal, industrial)

WELL COMPLETION DATA:
(1) diameter (inches) 2"
(2) total depth (feet) 336
(3) static water level (feet) 98' below (above) top of ground.
(4) casing 10' (material), 326, PVC. (depth)
— (size) If telescope see back.
(5) screen 10' (length), — (depth to top)
2" (size), plastic (material)
(6) pump 1 (HP) 14 (yield gpm)
electric (type power)
(7) electric log no (yes or no)
— (organization running log)
(8) how well bottom plugged Sand Stuck

DRILLERS REMARKS:

description of formations encountered	from	to
clay	0	42
sand	42	84
B. clay	84	157
slush	157	192
B. clay	192	231
f. sand	231	278
B. clay	278	297
C. sand	297	336

RECEIVED
MAY 4 - 1978
MISS. BD. OF WATER COMM.

If well telescopes please sketch and show depths.

GROUND LEVEL

If more than one screen, show locations of each on sketch.

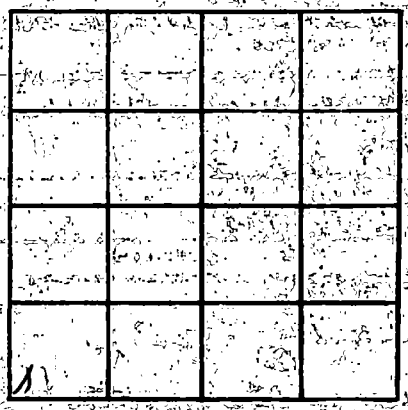

SECTION

Please indicate well location X.

ADDITIONAL INFORMATION