HARRISON
J 2050
1979

MISSISSIPPI
BOARD OF WATER COMMISSIONERS
416 North State Street
Jackson, Mississippi 39201

WATER WELL DRILLERS LOG

1979 — date well completed
Braden Pump & Well Service, Inc. — firm name
Harrison — county well located

LANDOWNER: General Supply Store
P.O. Box 56
Kiln, MS 39556
(mailing address)

WELL LOCATION:
sec. 30 T 7 N/S R 13 E/W
4 miles NW of DeLisle
(distance) (direction) (nearest town)

WELL PURPOSE: Store
(home, irrigation, municipal, industrial)

WELL COMPLETION DATA:
(1) diameter (inches) 2"
(2) total depth (feet) 430
(3) static water level (feet) 12 below ~~above~~ top of ground.
(4) casing PVC (material), Total (depth), 2" (size) if telescope see back.
(5) screen 10 ft (length), 410 (depth to top)
2" (size), PVC .008 Underdrain (material)
(6) pump 1 (HP) Jet 15 (yield gpm)
220 V 1 Ø (type power)
(7) electric log No (yes or no)
(organization running log)
(8) how well bottom plugged 2" Sand Plug

DRILLERS REMARKS:
0 ft tailpipe below screen

description of formations encountered	from	to
Red clay	0	20
Yellow clay	20	40
Blue clay	40	220
Clay & fine sand	220	260
Blue clay	260	320
Clay & fine sand	320	340
Blue clay	340	360
Clay & fine sand	360	380
Blue clay	380	390
Sand	390	425
Blue clay	425	430

Miss. Board of Water Comm.
JUN 18 1979
RECEIVED

If well telescopes please sketch and show depths.

GROUND LEVEL

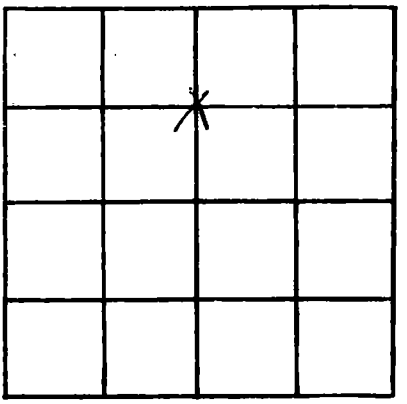

SECTION 30

Please indicate well location X.

ADDITIONAL INFORMATION

If more than one screen, show locations of each on sketch.