HARRISON
J 2060
5-29-79

MISSISSIPPI
BOARD OF WATER COMMISSIONERS
416 North State Street
Jackson, Mississippi 39201

WATER WELL DRILLERS LOG

5-29-79 (date well completed) 19 Switzer well Co. (firm name) Harrison (county well located)

LANDOWNER: Carson Stone
UNKNOWN AT PRESENT
(mailing address)

WELL LOCATION:
sec. 38 T 7 N (S) R 12 E (W)
6 miles (distance) N (direction) of Pass Christian (nearest town)

WELL PURPOSE: Home (home, irrigation, municipal, industrial)

WELL COMPLETION DATA:

(1) diameter (inches) 4X2
(2) total depth (feet) 560
(3) static water level (feet) 41' (below / above) top of ground.
(4) casing Steel (material), 540' (depth), 4X2 (size) If telescope see back.
(5) screen 20' (length), 540' (depth to top), 2" (size), Stainless Steel (material)
(6) pump 1 (HP) 19 (yield gpm) AC (type power)
(7) electric log NO (yes or no)
(organization running log)
(8) how well bottom plugged METAL BACKWASH

DRILLERS REMARKS:

description of formations encountered	from	to
Sandy Clay	0	19
Sand & Gravel & Clay Strs.	19	79
Clay with Sand & Gravel	79	88
gravel	88	96
Clay	96	122
Clay & Shale	122	161
Sand	161	167
Clay	167	201
Clay & Sand Streaks	201	213
Sand	213	221
Clay & Sand Streak	221	237
Clay	237	241
Clay & Shale	241	249
Sand	249	261
Clay & Shale	261	388
Clay & Sand Streaks	388	400
Clay & Shale	400	531
Sand & Gravel	531	560

Miss. Board of Water Comm.
JUL 6 1979
RECEIVED

If well telescopes please sketch and show depths.

GROUND LEVEL

200'
4"

340'
2"

20'
2" screen

If more than one screen, show locations of each on sketch.

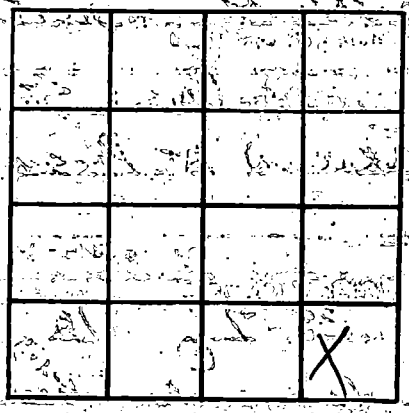

SECTION 38

Please indicate well location X.

ADDITIONAL INFORMATION