J 2113
Harrison
9-17-85

MISSISSIPPI DEPARTMENT OF NATURAL RESOURCES

Bureau of Land and Water Resources
Southport Mall
P.O. Box 10631
Jackson, Mississippi 39209

WATER WELL DRILLERS LOG

9-17 (date well completed) 19 85 McGill Pump + Well (firm name) Harrison (county well located)

LANDOWNER: Ralph H. Pearce
550 Peary Place
Gulfport Ms. 39501
(mailing address)

WELL LOCATION:
sec. 20 T 7 N (S) R 13 E (W)
4 (distance) miles N (direction) of Delisle (nearest town)

WELL PURPOSE: _____
(home, irrigation, municipal, industrial)

WELL COMPLETION DATA:

(1) diameter (inches) 2"

(2) total depth (feet) 320'

(3) static water level (feet) 50' (below) above top of ground.

(4) casing: Sch. 40 PVC (material), 310' (depth),
_____ (size) if telescope see back.

(5) screen 10' (length), 310' (depth to top)
2" (size), Sch. 80 PVC-6 Slot (material)

(6) pump 1 (HP) 7 (yield gpm)
Elec. (type power)

(7) electric log _____ (yes or no)
_____ (organization running log)

(8) how well bottom plugged SAND SHARK

DRILLERS REMARKS: _____

description of formations encountered	from	to
Mud	0	140
Mud / Sand	140	180
Mud	180	200
Mud / Sand	200	240
Mud	240	260
Sand	260	320

RECEIVED
OCT - 8 1985
Department of Natural Resources
Bureau of Land & Water Resources

If well telescopes please sketch and show depths.

GROUND LEVEL

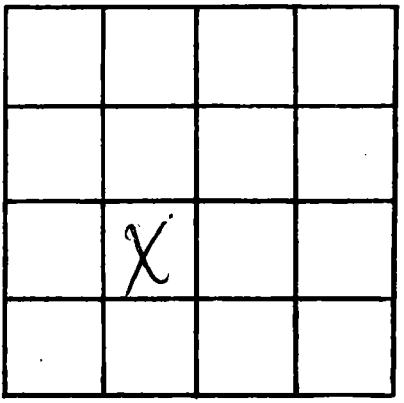

SECTION _____

Please indicate well location X.

ADDITIONAL INFORMATION

If more than one screen, show locations of each on sketch.