MISSISSIPPI DEPARTMENT OF NATURAL RESOURCES

Bureau of Land and Water Resources

P.O. Box 10631
Jackson, Mississippi 39209

WATER WELL DRILLERS LOG

COUNTY WELL LOCATED: Harrison	
WELL NUMBER: 3	CODED:
2131	
DATE WELL COMPLETED: Sept. 2-86	

PERMIT NUMBER	
NAME OF DRILLING FIRM: McHill Pump & Wells	

NAME & MAILING ADDRESS OF LANDOWNER
Darien Radner
Rt. 3, Box 310
Pass Christian Ms. 39571

WELL LOCATION: SEC 19 TOWNSHIP 7 (N) (S) RANGE 13 (E) (W)

DISTANCE 6 Miles DIRECTION East of NEAREST TOWN Kiln

OTHER LANDMARK

WELL PURPOSE: Home, Irrigation, Municipal, Industrial, Fish Pond, etc.
Home

PUMP DATA

PUMP TYPE (Circle One): Submersible, Turbine, (Jet) Flowing Well, Other (Describe) _____

POWER TYPE (Circle One): (Electric) Tractor, Diesel, Gasoline, Butane, Other (Describe) _____

Pump Capacity (GPM)	No. of Stages	Setting Depth
15	2	40' FT.

PUMP TEST

Well yielded 15 GPM with a drawdown of 3 ft. after 1 hours of pumping

WELL DATA

Well Depth	Casing Diameter (In.)	Casing Length (Ft.)
230'	2"	220'
Type of Casing	**Hole Depth**	**Depth to Static Water Level**
PVC	235'	15'

TYPE OF COMPLETION: (Circle One or More): Gravel Packed, Underreamed, Telescoped, (Natural Development) Open Hole, Other (Describe) _____

Top of Lap Pipe or Reduction in Casing FEET

IF TELESCOPED OR MORE THAN ONE SCREEN: USE BACK PAGE

LOG DATA

TYPE OF LOG RUN (Circle One): (No Log Run) Electric, Gamma Ray, Density, Sonic, Neutron, Other (Describe) _____

Name of Organization Running Log

GEOLOGIC DATA (Office Use Only)

Surface Elev.	Geologic Unit	Unit Thickness	Depth to Top
Subs. SWL	Date	Analysis	Aquifer Test

Driller's Remarks

SCREEN DATA

Diameter - Inches	Length - Feet	Slot Size - Inches
2"	10'	6 Ths
Screen Type		**Depth to Bottom - Feet**
PVC		230'

DESCRIPTION OF FORMATIONS ENCOUNTERED	FROM	TO
mud	0	10
Sand	10	25
mud	25	40
Sand	40	60
mud	60	180
Sand	180	230

FORMATIONS (Continued) FROM TO

IF MORE SPACE IS NEEDED, USE BACK

RECEIVED
NOV 3 1986
Department of Natural Resources
Bureau of Land & Water Resources

If well telescopes please sketch and show depths.

GROUND LEVEL

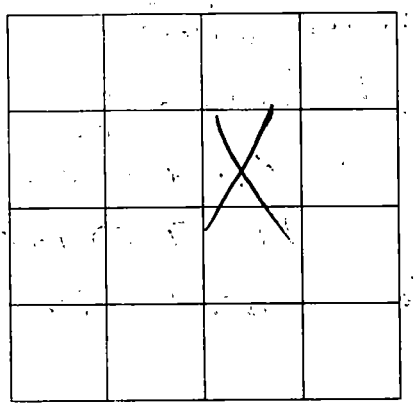

SECTION _____

Please indicate well location X.

ADDITIONAL INFORMATION

If more than one screen, show location of each on sketch.