MISSISSIPPI DEPARTMENT OF NATURAL RESOURCES

Bureau of Land and Water Resources

P.O. Box 10631
Jackson, Mississippi 39209

WATER WELL DRILLERS LOG

COUNTY WELL LOCATED: Harrison

WELL NUMBER: J 2135 CODED

DATE WELL COMPLETED: Nov. 7-86

PERMIT NUMBER: 0239

NAME OF DRILLING FIRM: McGill Pump & Well

NAME & MAILING ADDRESS OF LANDOWNER: Richard Burgess, Hayes rd, Long Beach Ms.

WELL LOCATION: SEC 28 TOWNSHIP 7 (N) (S) RANGE 13 (E) (W)

DISTANCE 1 Miles DIRECTION South of NEAREST TOWN I-10

OTHER LANDMARK: Long Beach Exit

WELL PURPOSE: (Home) Irrigation, Municipal, Industrial, Fish Pond, etc.

PUMP DATA

PUMP TYPE (Circle One): (Submersible) Turbine, Jet, Flowing Well, Other (Describe) 1hp jacuzzi

POWER TYPE (Circle One): Electric, Tractor, Diesel, Gasoline, Butane, Other (Describe)

Pump Capacity (GPM)	No. of Stages	Setting Depth
25		100' FT.

PUMP TEST

Well yielded 25 GPM with a drawdown of 10' ft. after 1 hours of pumping

WELL DATA

Well Depth	Casing Diameter (In.)	Casing Length (Ft.)
520'	4"x2"	520'

Type of Casing	Hole Depth	Depth to Static Water Level
PVC	520'	60'

TYPE OF COMPLETION: (Circle One or More): Gravel Packed, Underreamed, Telescoped, (Natural Development) Open Hole, Other (Describe)

Top of Lap Pipe or Reduction in Casing: FEET

IF TELESCOPED OR MORE THAN ONE SCREEN: USE BACK PAGE

SCREEN DATA

Diameter - Inches	Length - Feet	Slot Size - Inches
2"	20'	6 Ths

Screen Type	Depth to Bottom - Feet
PVC	520'

LOG DATA

TYPE OF LOG RUN (Circle One): (Electric) Gamma Ray, Density, Sonic, Neutron, No Log Run, Other (Describe)

Name of Organization Running Log

GEOLOGIC DATA (Office Use Only)

Surface Elev.	Geologic Unit	Unit Thickness	Depth to Top
Subs. SWL	Date	Analysis	Aquifer Test

Driller's Remarks

RECEIVED
JAN 14 1987
Department of Natural Resources
Bureau of Land & Water Resources

DESCRIPTION OF FORMATIONS ENCOUNTERED	FROM	TO	FORMATIONS (Continued)	FROM	TO
			IF MORE SPACE IS NEEDED, USE BACK		

If well telescopes please
sketch and show depts.

GROUND LEVEL

4" = 140'
2" = 380'
520'

If more than one screen,
show location of each on sketch.

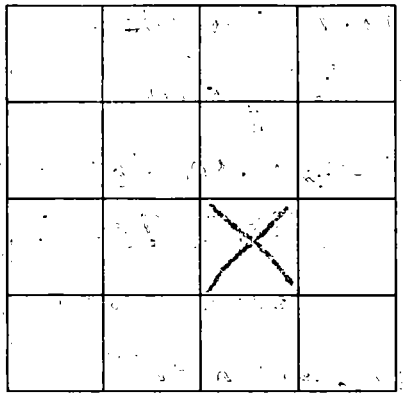

SECTION _____

Please indicate well location X.

ADDITIONAL INFORMATION