MISSISSIPPI DEPARTMENT OF NATURAL RESOURCES

Bureau of Land and Water Resources

P.O. Box 10631
Jackson, Mississippi 39209

WATER WELL DRILLERS LOG

COUNTY WELL LOCATED: Harrison	PERMIT NUMBER: 0239
WELL NUMBER: J 2154 / CODED:	NAME OF DRILLING FIRM: McGill Pump & Well
DATE WELL COMPLETED: 3/11/88	

NAME & MAILING ADDRESS OF LANDOWNER
Nicholas Podluski
P.O. Box 175
Long Beach Ms. 39560

WELL LOCATION: SEC 36 TOWNSHIP 7 N (S) RANGE 13 (W) E

DISTANCE 1 Miles DIRECTION South of NEAREST TOWN ~~7~~-10 of Menge

OTHER LANDMARK

WELL PURPOSE: (Home) Irrigation, Municipal, Industrial, Fish Pond, etc.

PUMP DATA

PUMP TYPE (Circle One): (Submersible) Turbine, Jet Flowing Well, Other (Describe)

POWER TYPE (Circle One): (Electric) Tractor, Diesel, Gasoline, Butane, Other (Describe)

Pump Capacity (GPM)	No. of Stages	Setting Depth
18		100' FT.

PUMP TEST

Well yielded 18 GPM with a drawdown of 20 ft. after 1 hours of pumping

WELL DATA

Well Depth	Casing Diameter (In.)	Casing Length (Ft.)
580'	4"x2"	560'

Type of Casing	Hole Depth	Depth to Static Water Level
PVC	580	60'

TYPE OF COMPLETION: (Circle One or More): Gravel Packed, Underreamed, Telescoped, (Natural Development) Open Hole, Other (Describe)

Top of Lap Pipe or Reduction in Casing FEET

IF TELESCOPED OR MORE THAN ONE SCREEN: USE BACK PAGE

SCREEN DATA

Diameter - Inches	Length - Feet	Slot Size - Inches
2"	20'	6ths.

Screen Type	Depth to Bottom - Feet
PVC	580'

LOG DATA

TYPE OF LOG RUN (Circle One): (No Log Run) Electric, Gamma Ray, Density, Sonic, Neutron, Other (Describe)

Name of Organization Running Log

GEOLOGIC DATA (Office Use Only)

Surface Elev.	Geologic Unit	Unit Thickness	Depth to Top
Subs. SWL	Date	Analysis	Aquifer Test

Driller's Remarks

RECEIVED
APR 15 1989
Department of Natural Resources
Bureau of Land & Water Resources

DESCRIPTION OF FORMATIONS ENCOUNTERED	FROM	TO
Sand	0	120
mud	120	200
Sand	200	230
mud	230	380
Sand	380	410
mud	410	520
Sand	520	580

FORMATIONS Continued	FROM	TO

IF MORE SPACE IS NEEDED, USE BACK

If well telescopes please
sketch and show depths.

GROUND LEVEL

150' - 4" Top
400' : 2" bottom

If more than one screen,
show location of each on sketch.

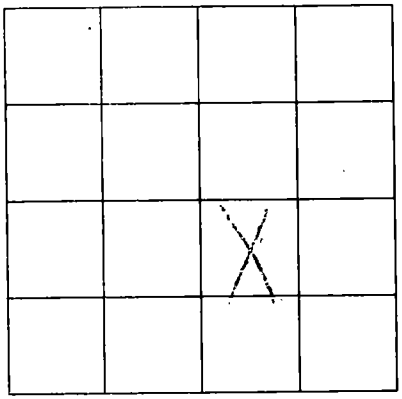

SECTION _____

Please indicate well location X.

ADDITIONAL INFORMATION