MISSISSIPPI DEPARTMENT OF NATURAL RESOURCES

Bureau of Land and Water Resources

P.O. Box 10631
Jackson, Mississippi 39209

WATER WELL DRILLERS LOG

COUNTY WELL LOCATED: Harrison	
WELL NUMBER: J	CODED:
DATE WELL COMPLETED: 2174	
PERMIT NUMBER: 0239	
NAME OF DRILLING FIRM: McGill	

NAME & MAILING ADDRESS OF LANDOWNER: 16 Section Rd, Pass Christian, Ms.

WELL LOCATION: SEC 16 TOWNSHIP 7 N/S RANGE 13 E/W

DISTANCE 2 Miles DIRECTION E of NEAREST TOWN Videlia rd

OTHER LANDMARK: Videlia Rd.

WELL PURPOSE: Home, Irrigation, Municipal, Industrial, Fish Pond, etc.

PUMP DATA

PUMP TYPE (Circle One): Submersible, Turbine, Jet, Flowing Well, Other (Describe) _____

POWER TYPE (Circle One): Electric, Tractor, Diesel, Gasoline, Butane, Other (Describe) _____ H/P _____

Pump Capacity (GPM)	No. of Stages	Setting Depth
15	2	25 FT.

PUMP TEST: Well yielded 12 GPM with a drawdown of 10 ft. after 1 hours of pumping

WELL DATA

Well Depth	Casing Diameter (in.)	Casing Length (Ft.)
300'	2	290

Type of Casing	Hole Depth	Depth to Static Water Level
PVC	300'	15

TYPE OF COMPLETION: (Circle One or More): Gravel Packed, Underreamed, Telescoped, ~~Natural Development~~, Open Hole, Other (Describe) _____

Top of Lap Pipe or Reduction in Casing: FEET

IF TELESCOPED OR MORE THAN ONE SCREEN: USE BACK PAGE

SCREEN DATA

Diameter - Inches	Length - Feet	Slot Size - Inches
2	10	.0006

Screen Type	Depth to Bottom - Feet
PVC	300

LOG DATA

TYPE OF LOG RUN (Circle One): Electric, Gamma Ray, Density, Sonic, Neutron, Other (Describe) _____, No Log Run

Name of Organization Running Log

GEOLOGIC DATA (Office Use Only)

Surface Elev.	Geologic Unit	Unit Thickness	Depth to Top
Subs. SWL	Date	Analysis	Aquifer Test

Driller's Remarks

DESCRIPTION OF FORMATIONS ENCOUNTERED	FROM	TO	FORMATIONS (Continued)	FROM	TO
MUD	0	240			
MUD SAND	240	260			
SAND	260	300			
			IF MORE SPACE IS NEEDED, USE BACK		

RECEIVED
AUG 24 1990
Department of Natural Resources
Bureau of Land & Water Resources

If well telescopes please sketch and show depths.

GROUND LEVEL

If more than one screen, show location of each on sketch.

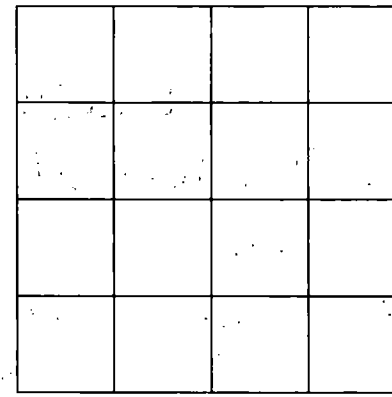

SECTION _____

Please indicate well location X.

ADDITIONAL INFORMATION