MISSISSIPPI DEPARTMENT OF NATURAL RESOURCES

Bureau of Land and Water Resources

P.O. Box 10631
Jackson, Mississippi 39209

WATER WELL DRILLERS LOG

COUNTY WELL LOCATED: Harrison

WELL NUMBER: J — CODED:

2177

DATE WELL COMPLETED: 1-16-90

PERMIT NUMBER: 0239

NAME OF DRILLING FIRM: Mcgill

NAME & MAILING ADDRESS OF LANDOWNER

Cuevas rd

Kiln, Ms.

WELL LOCATION: SEC 29 TOWNSHIP 7 N S RANGE 13 E W

DISTANCE 5 Miles DIRECTION N of NEAREST TOWN I-10

OTHER LANDMARK

WELL PURPOSE: (Home), Irrigation, Municipal, Industrial, Fish Pond, etc.

PUMP DATA

PUMP TYPE (Circle One): Submersible, Turbine, (Jet), Flowing Well, Other (Describe) _____

POWER TYPE (Circle One): (Electric), Tractor, Diesel, Gasoline, Butane, Other (Describe) _____

Pump Capacity (GPM)	No. of Stages	Setting Depth
15	2	40 FT.

PUMP TEST

Well yielded 10 GPM with a drawdown of 10 ft. after 1 hours of pumping

WELL DATA

Well Depth	Casing Diameter (In.)	Casing Length (Ft.)
500'	2	490

Type of Casing	Hole Depth	Depth to Static Water Level
PVC	500'	~20'

TYPE OF COMPLETION: (Circle One or More): Gravel Packed, Underreamed, Telescoped, Natural Development, Open Hole, Other (Describe) _____

Top of Lap Pipe or Reduction in Casing

FEET

IF TELESCOPED OR MORE THAN ONE SCREEN: USE BACK PAGE

SCREEN DATA

Diameter - Inches	Length - Feet	Slot Size - Inches
2	10	.0006

Screen Type	Depth to Bottom - Feet
PVC	500

LOG DATA

TYPE OF LOG RUN (Circle One): (No Log Run), ~~Electric~~, Gamma Ray, Density, Sonic, Neutron, Other (Describe) _____

Name of Organization Running Log

GEOLOGIC DATA (Office Use Only)

Surface Elev.	Geologic Unit	Unit Thickness	Depth to Top
Subs. SWL	Date	Analysis	Aquifer Test

Driller's Remarks

DESCRIPTION OF FORMATIONS ENCOUNTERED	FROM	TO
MUD, SAND	0	20
SAND	20	100
SAND, gravel	100	140
SAND	140	160
SAND MUD	160	180
MUD	180	200
MUD, SAND	200	220
MUD	220	300
MUD, SAND	300	320
MUD	320	440
MUD, SAND	440	500

FORMATION	FROM	TO
SAND	440	500

IF MORE SPACE IS NEEDED, USE BACK

RECEIVED
AUG 24 1990
Department of Natural Resources
Bureau of Land & Water Resources

If well telescopes please sketch and show depths.

GROUND LEVEL

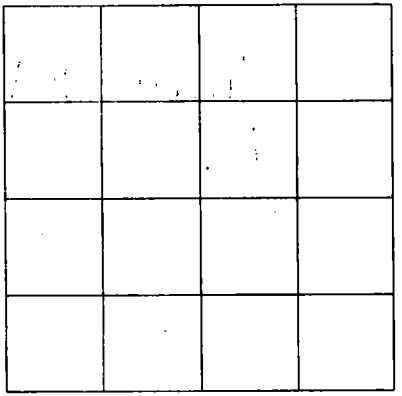

SECTION _____

Please indicate well location X.

ADDITIONAL INFORMATION

If more than one screen, show location of each on sketch.