MISSISSIPPI DEPARTMENT OF ENVIRONMENTAL QUALITY
Bureau of Land and Water Resources

P. O. Box 10631
Jackson, MS 39289-0631

WATER WELL DRILLERS LOG

COUNTY WELL LOCATED	Harrison
WELL NUMBER	7
CODED	
	2183
DATE WELL COMPLETED	9/13/90
PERMIT NUMBER	0239
NAME OF DRILLING FIRM	McGill Pump

NAME & MAILING ADDRESS OF LANDOWNER
Valarie Malley
Duckheision Rd
Pass Christian Ms.

WELL LOCATION: SEC 13 TOWNSHIP 7S RANGE 13 E/W

DISTANCE 4 Miles **DIRECTION** North of **NEAREST TOWN** Pineville

OTHER LANDMARK

WELL PURPOSE: Home, Irrigation, Municipal, Industrial, Fish Pond, etc.

PUMP DATA

PUMP TYPE (Circle One): Submersible, Turbine, Jet, Flowing Well, Other (Describe) _____

POWER TYPE (Circle One): Electric, Tractor, Diesel, Gasoline, Butane, Other (Describe) _____ H/P _____

Pump Capacity (GPM)	No. of Stages	Setting Depth
12	2	80' FT.

PUMP TEST

Well yielded 10 GPM with a drawdown of 9 ft. after 1 hours of pumping

WELL DATA

Well Depth	Casing Diameter (In.)	Casing Length (Ft.)
440'	2"	420'

Type of Casing	Hole Depth	Depth to Static Water Level
PVC	440'	60'

TYPE OF COMPLETION: (Circle One or More): Gravel Packed, Underreamed, Telescoped, Natural Development, Open Hole, Other (Describe) _____

Top of Lap Pipe or Reduction in Casing FEET

IF TELESCOPED OR MORE THAN ONE SCREEN: USE BACK PAGE

LOG DATA

TYPE OF LOG RUN (Circle One): No Log Run, Electric, Gamma Ray, Density, Sonic, Neutron, Other (Describe) _____

Name of Organization Running Log

GEOLOGIC DATA (Office Use Only)

Surface Elev.	Geologic Unit	Unit Thickness	Depth to Top
Subs. SWL			Water Test
Driller's Rem			

RECEIVED
DEC 02 1991
Dept. of Environmental Quality
Bureau of Land & Water Resources

SCREEN DATA

Diameter - Inches	Length - Feet	Slot Size - Inches
2"	10'	.0006

Screen Type	Depth to Bottom - Feet
PVC	440'

DESCRIPTION OF FORMATIONS ENCOUNTERED	FROM	TO	FORMATIONS (Continued)		TO
Mud	0	60			
Sand	60	140			
mud	140	150			
Sand	150	310			
mud	310	410			
Sand	410	440			
			IF MORE SPACE IS NEEDED, USE BACK		

If well telescopes please sketch and show depths.

GROUND LEVEL

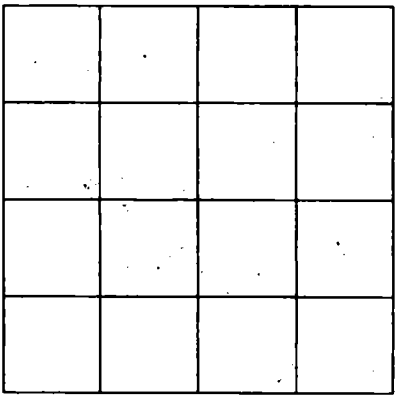

SECTION _____

Please indicate well location X.

ADDITIONAL INFORMATION

RECEIVED
DEC 09 1991
Dept. of Environmental Quality
Bureau of Land & Water Resources

If more than one screen, show location of each on sketch.