MISSISSIPPI DEPARTMENT OF ENVIRONMENTAL QUALITY
Bureau of Land and Water Resources

P. O. Box 10631
Jackson, MS 39289-0631
WATER WELL DRILLERS LOG

COUNTY WELL LOCATED: Harrison	
WELL NUMBER: J	CODED:
2185	
DATE WELL COMPLETED: 3/23/91	

PERMIT NUMBER: 0039	
NAME OF DRILLING FIRM: McCall Pump & Well	

NAME & MAILING ADDRESS OF LANDOWNER
Glen Price
24344 E. Dulmission Rd
Pass Christian Ms.

WELL LOCATION: SEC 13 TOWNSHIP 9 N (S) RANGE 13 E (W)

DISTANCE 2 Miles DIRECTION West of NEAREST TOWN Gpt.

OTHER LANDMARK

WELL PURPOSE: Home, Irrigation, Municipal, Industrial, Fish Pond, etc.

PUMP DATA

PUMP TYPE (Circle One): Submersible, Turbine, Jet, Flowing Well, Other (Describe)

POWER TYPE (Circle One): Electric, Tractor, Diesel, Gasoline, Butane, Other (Describe) H/P

Pump Capacity (GPM)	No. of Stages	Setting Depth
18	18	120' FT.

PUMP TEST

Well yielded 25 GPM with a drawdown of 15 ft. after 1 hours of pumping

WELL DATA

Well Depth	Casing Diameter (In.)	Casing Length (Ft.)
500'	4"X2"	490'

Type of Casing	Hole Depth	Depth to Static Water Level
PVC	500'	80'

TYPE OF COMPLETION: (Circle One or More): Gravel Packed, Underreamed, Telescoped, Natural Development, Open Hole, Other (Describe)

Top of Lap Pipe or Reduction in Casing FEET

IF TELESCOPED OR MORE THAN ONE SCREEN: USE BACK PAGE

SCREEN DATA

Diameter - Inches	Length - Feet	Slot Size - Inches
2"	20'	.0006

Screen Type	Depth to Bottom - Feet
PVC	500'

LOG DATA

TYPE OF LOG RUN (Circle One): No Log Run, Electric, Gamma Ray, Density, Sonic, Neutron, Other (Describe)

Name of Organization Running Log

GEOLOGIC DATA (Office Use Only)

Surface Elev.	Geologic Unit	Unit Thickness	Depth to Top
Subs. SWL	Date	Analysis	Aquifer Test

Driller's Remarks

DESCRIPTION OF FORMATIONS ENCOUNTERED	FROM	TO
Mud	0	10
Sand/Gravel	10	70
Mud	70	280
Sand	280	290
Mud	290	460
Sand	460	500

IF MORE SPACE IS NEEDED, USE BACK

RECEIVED
DEC 02 1991
Dept. of Environmental Quality
Bureau of Land & Water Resources

If well telescopes please sketch and show depths.

GROUND LEVEL

200' = 4" Top
300' = 2" Bottom

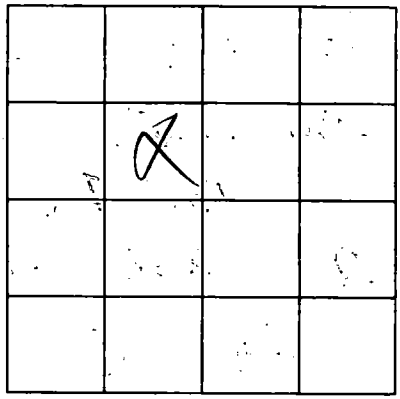

SECTION _____

Please indicate well location X.

ADDITIONAL INFORMATION

RECEIVED

If more than one screen, show location of each on sketch.