MISSISSIPPI DEPARTMENT OF ENVIRONMENTAL QUALITY
Bureau of Land and Water Resources

P. O. Box 10631
Jackson, MS 39289-0631
WATER WELL DRILLERS LOG

COUNTY WELL LOCATED: Hinds	
WELL NUMBER: I 2197	CODED
DATE WELL COMPLETED: 5-1-92	
PERMIT NUMBER: C-239	
NAME OF DRILLING FIRM: McGill	

NAME & MAILING ADDRESS OF LANDOWNER
Lewis Parker
26178 W. Maple Rd.
Kiss Christian, Mo.

WELL LOCATION: SEC 34 TOWNSHIP 7 N/S RANGE 13 E/W

DISTANCE ____ Miles DIRECTION ____ of NEAREST TOWN ____

OTHER LANDMARK

WELL PURPOSE: Home, Irrigation, Municipal, Industrial, Fish Pond, etc.

PUMP DATA

PUMP TYPE (Circle One): Submersible, Turbine, Jet, Flowing Well, Other (Describe) ____

POWER TYPE (Circle One): Electric, Tractor, Diesel, Gasoline, Butane, Other (Describe) ____ H/P 1

Pump Capacity (GPM)	No. of Stages	Setting Depth
15	2	80 FT.

PUMP TEST

Well yielded 8 GPM with a drawdown of ____ ft. after 1 hours of pumping

WELL DATA

Well Depth	Casing Diameter (In.)	Casing Length (Ft.)
560	2	20

Type of Casing	Hole Depth	Depth to Static Water Level
PVC	560	60

TYPE OF COMPLETION: (Circle One or More): ~~Gravel Packed~~, Underreamed, Telescoped, Natural Development, Open Hole, Other (Describe) ____

Top of Lap Pipe or Reduction in Casing FEET

IF TELESCOPED OR MORE THAN ONE SCREEN: USE BACK PAGE

SCREEN DATA

Diameter Inches	Length - Feet	Slot Size - Inches
2	10	0006

Screen Type	Depth to Bottom - Feet
PVC	550

LOG DATA

TYPE OF LOG RUN (Circle One): No Log Run, Electric, Gamma Ray, Density, Sonic, Neutron, Other (Describe) ____

Name of Organization Running Log

GEOLOGIC DATA (Office Use Only)

Surface Elev.	Geologic Unit	Unit Thickness	Depth to Top
Subs. SWL	Date	Analysis	Aquifer Test

Driller's Remarks

DESCRIPTION OF FORMATIONS ENCOUNTERED	FROM	TO	FORMATION DESCRIPTION	FROM	TO
			IF MORE SPACE IS NEEDED, USE BACK		

RECEIVED
OCT 07 1992
Dept. of Environmental Quality
Bureau of Land & Water Resources

If well telescopes please sketch and show depths.

GROUND LEVEL

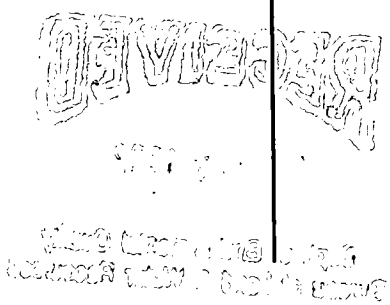

If more than one screen, show location of each on sketch.

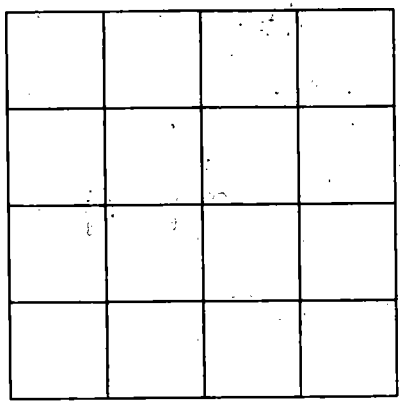

SECTION _____

Please indicate well location X.

ADDITIONAL INFORMATION