MISSISSIPPI DEPARTMENT OF ENVIRONMENTAL QUALITY
Office of Land and Water Resources

P. O. Box 10631
Jackson, MS 39289-0631
WATER WELL DRILLERS LOG

COUNTY WELL LOCATED: Harrison	PERMIT NUMBER: 0-239
WELL NUMBER: J 23/0 CODED:	NAME OF DRILLING FIRM: Mc Bee
DATE WELL COMPLETED: 3-26-96	

NAME & MAILING ADDRESS OF LANDOWNER
Thomas Doss
8712 Pine Ridge Blvd.
Pass Chr., MS. 39525

WELL LOCATION SEC	TOWNSHIP	RANGE
36	7 (S) N	13 (W) E

DISTANCE	DIRECTION	NEAREST TOWN
1 Miles	North of	I 10

OTHER LANDMARK

WELL PURPOSE: (Home) Irrigation, Municipal, Industrial, Fish Pond, etc.

PUMP DATA

PUMP TYPE (Circle One): Submersible, Turbine, (Jet) Flowing Well, Other (Describe)

POWER TYPE (Circle One): (Electric) Tractor, Diesel, Gasoline, Butane, Other (Describe) H/P 1

Pump Capacity (GPM)	No. of Stages	Setting Depth
15	2	60 FT.

PUMP TEST
Well yielded 12 GPM with a drawdown of 8 ft. after 1 hours of pumping

WELL DATA

Well Depth	Casing Diameter (In.)	Casing Length (Ft.)
220'	2	200

Type of Casing	Hole Depth	Depth to Static Water Level
PVC	220'	

TYPE OF COMPLETION: (Circle One or More): Gravel Packed, Underreamed, Telescoped, ~~Natural Development~~, Open Hole, Other (Describe)

WELL GROUTED TO A DEPTH OF 10 FEET
Type Grout (circle one): Cement, Bentonite, or Mix

LOG DATA

TYPE OF LOG RUN (Circle One): ~~No Log Run~~, Electric, Gamma Ray, Density, Sonic, Neutron, Other (Describe)

Name of Organization Running Log

GEOLOGIC DATA (Office Use Only)

Surface Elev.	Geologic Unit	Unit Thickness	Depth to Top
Subs. SWL	Date	Analysis	Aquifer Test

Driller's Remarks

SCREEN DATA

Diameter - Inches	Length - Feet	Slot Size - Inches
2"	20	0006

Screen Type	Depth to Bottom - Feet
PVC	200

Top of Lap Pipe or Reduction in Casing
FEET — IF TELESCOPED OR MORE THAN ONE SCREEN: USE BACK PAGE

DESCRIPTION OF FORMATIONS ENCOUNTERED	FROM	TO	FORMATIONS (Continued)	FROM	TO
mud	0	180			
Sand	180	220			
			IF MORE SPACE IS NEEDED, USE BACK		

RECEIVED
MAR 17 1997
Dept. of Environmental Quality
Office of Land & Water Resources

If well telescopes please sketch and show depths.

GROUND LEVEL

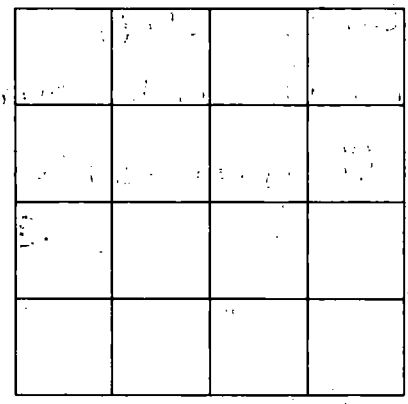

SECTION _____

Please indicate well location X.

ADDITIONAL INFORMATION

If more than one screen, show location of each on sketch.