MISSISSIPPI DEPARTMENT OF ENVIRONMENTAL QUALITY
Office of Land and Water Resources

P. O. Box 10631
Jackson, MS 39289-0631
WATER WELL DRILLERS LOG

COUNTY WELL LOCATED: HARRISON
WELL NUMBER: J 23/1 CODED
DATE WELL COMPLETED: 2-7-97

PERMIT NUMBER: O-239
NAME OF DRILLING FIRM: McGill

NAME & MAILING ADDRESS OF LANDOWNER: Tommy Cuevas
Placide Rd.
Pass Chr. Ms.

WELL LOCATION: SEC 13 TOWNSHIP 7 (N) (S) RANGE 13 (E) (W)

DISTANCE 2 Miles DIRECTION North of NEAREST TOWN I-10

OTHER LANDMARK

WELL PURPOSE: (Home), Irrigation, Municipal, Industrial, Fish Pond, etc.

PUMP DATA

PUMP TYPE (Circle One): Submersible, Turbine, (Jet) Flowing Well, Other (Describe) _____

POWER TYPE (Circle One): (Electric), Tractor, Diesel, Gasoline, Butane, Other (Describe) _____ H/P _____

Pump Capacity (GPM)	No. of Stages	Setting Depth
15	2	120 FT.

PUMP TEST

Well yielded 10 GPM with a drawdown of 1 ft. after 1 hours of pumping

WELL DATA

Well Depth	Casing Diameter (In.)	Casing Length (Ft.)
560'	2	540

Type of Casing	Hole Depth	Depth to Static Water Level
PVC	560	100'

TYPE OF COMPLETION: (Circle One or More): Gravel Packed, Underreamed, Telescoped, Natural Development, Open Hole, Other (Describe) _____

WELL GROUTED TO A DEPTH OF 10 FEET
Type Grout (circle one): Cement, Bentonite, or Mix

LOG DATA

TYPE OF LOG RUN (Circle One): (No Log Run), Electric, Gamma Ray, Density, Sonic, Neutron, Other (Describe) _____

Name of Organization Running Log

GEOLOGIC DATA (Office Use Only)

Surface Elev.	Geologic Unit	Unit Thickness	Depth to Top
Subs. SWL	Date	Analysis	Aquifer Test

Driller's Remarks

Top of Lap Pipe or Reduction in Casing FEET

IF TELESCOPED OR MORE THAN ONE SCREEN: USE BACK PAGE

SCREEN DATA

Diameter - Inches	Length - Feet	Slot Size - Inches
2	20	.006

Screen Type	Depth to Bottom - Feet
PVC	540

DESCRIPTION OF FORMATIONS ENCOUNTERED	FROM	TO
Sand	0	20
Mud	20	200
Mud & Sand	200	500
Sand	500	560

FORMATIONS (Continued) FROM TO

IF MORE SPACE IS NEEDED, USE BACK

RECEIVED
MAR 17 1997
Dept. of Environmental Quality
Office of Land & Water Resources

If well telescopes please sketch and show depths.

GROUND LEVEL

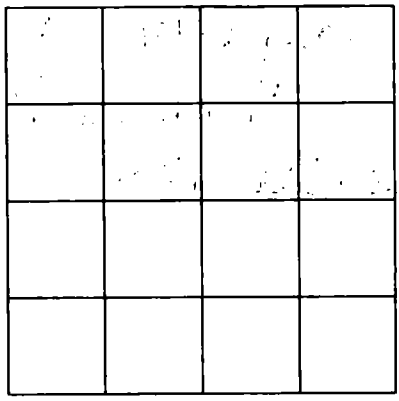

SECTION _____

Please indicate well location X.

ADDITIONAL INFORMATION

If more than one screen, show location of each on sketch.