MISSISSIPPI DEPARTMENT OF ENVIRONMENTAL QUALITY
Office of Land and Water Resources

P. O. Box 10631
Jackson, MS 39289-0631
WATER WELL DRILLERS LOG

COUNTY WELL LOCATED	Harrison
WELL NUMBER	J 2314
CODED	
DATE WELL COMPLETED	12/6/95
PERMIT NUMBER	0239
NAME OF DRILLING FIRM	McGill Pump & Well

NAME & MAILING ADDRESS OF LANDOWNER
Strahan Investments
Lot 2 Vidalia rd.
Pass Christian Ms.

WELL LOCATION SEC	TOWNSHIP	RANGE
33	7 N (S)	13 E (W)

DISTANCE	DIRECTION	NEAREST TOWN
3 Miles	north of	Delisle

OTHER LANDMARK

WELL PURPOSE: (Home) Irrigation, Municipal, Industrial, Fish Pond, etc.

PUMP DATA

PUMP TYPE (Circle One): Submersible, Turbine, (Jet) Flowing Well, Other (Describe) ____

POWER TYPE (Circle One): (Electric) Tractor, Diesel, Gasoline, Butane, Other (Describe) ____ H/P 1

Pump Capacity (GPM)	No. of Stages	Setting Depth
12	2	60' FT.

PUMP TEST

Well yielded 12 GPM with a drawdown of 10 ft. after 12 hours of pumping

WELL DATA

Well Depth	Casing Diameter (In.)	Casing Length (Ft.)
500'	2"	480'

Type of Casing	Hole Depth	Depth to Static Water Level
PVC	500'	40'

TYPE OF COMPLETION: (Circle One or More): Gravel Packed, Underreamed, Telescoped, (Natural Development) Open Hole, Other (Describe) ____

WELL GROUTED TO A DEPTH OF 10 FEET
Type Grout (circle one): Cement, Bentonite, or Mix

LOG DATA

TYPE OF LOG RUN (Circle One): (No Log Run) Electric, Gamma Ray, Density, Sonic, Neutron, Other (Describe) ____

Name of Organization Running Log

GEOLOGIC DATA (Office Use Only)

Surface Elev.	Geologic Unit	Unit Thickness	Depth to Top
Subs. SWL	Date	Analysis	Aquifer Test

Driller's Remarks

SCREEN DATA

Diameter - Inches	Length - Feet	Slot Size - Inches
2"	20'	.0006

Screen Type	Depth to Bottom - Feet
PVC	500'

Top of Lap Pipe or Reduction in Casing
FEET — IF TELESCOPED OR MORE THAN ONE SCREEN: USE BACK PAGE

DESCRIPTION OF FORMATIONS ENCOUNTERED	FROM	TO
mud	0	80
sand	80	100
mud	100	320
sand	320	345
mud	345	460
sand	460	500

FORMATIONS (Continued)	FROM	TO

JUN 30 1997
Office of Environmental Quality
Office of Land & Water Resources

IF MORE SPACE IS NEEDED, USE BACK

If well telescopes please sketch and show depths.

GROUND LEVEL

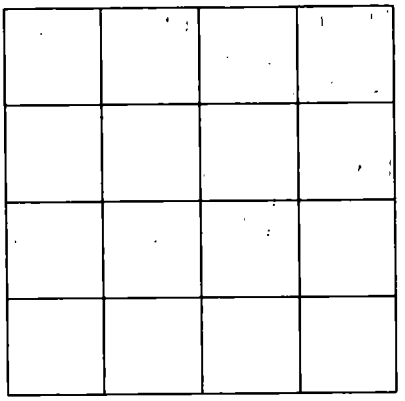

SECTION _____

Please indicate well location X.

ADDITIONAL INFORMATION

If more than one screen, show location of each on sketch.