MISSISSIPPI DEPARTMENT OF ENVIRONMENTAL QUALITY
Office of Land and Water Resources

P. O. Box 10631
Jackson, MS 39289-0631
WATER WELL DRILLERS LOG

COUNTY WELL LOCATED	Harrison
WELL NUMBER	J-2339
CODED	
DATE WELL COMPLETED	01-17-01
PERMIT NUMBER	O-239
NAME OF DRILLING FIRM	McGill Pump & Well

NAME & MAILING ADDRESS OF LANDOWNER
J. R. Holdren
Walnut Rd.
Pass Christian 39571

WELL LOCATION SEC	TOWNSHIP	RANGE
34	7 N (S)	13 E (W)

DISTANCE _____ Miles DIRECTION _____ of NEAREST TOWN _____

OTHER LANDMARK

WELL PURPOSE (Home) Irrigation, Municipal, Industrial, Fish Pond, etc.

PUMP DATA

PUMP TYPE (Circle One): Submersible, Turbine, (Jet) Flowing Well, Other (Describe) _____

POWER TYPE (Circle One): (Electric) Tractor, Diesel, Gasoline, Butane, Other (Describe) _____ H/P 1hp

Pump Capacity (GPM)	No. of Stages	Setting Depth
6	2	100 FT.

PUMP TEST

Well yielded 6 GPM with a drawdown of 5 ft. after 5 hours of pumping

WELL DATA

Well Depth	Casing Diameter (In.)	Casing Length (Ft.)
660'	2"	640'
Type of Casing	**Hole Depth**	**Depth to Static Water Level**
PVC	660'	80'

TYPE OF COMPLETION: (Circle One or More): Gravel Packed, Underreamed, Telescoped, (Natural Development) Open Hole, Other (Describe) _____

WELL GROUTED TO A DEPTH OF 10 FEET
Type Grout (circle one): (Cement), Bentonite, or Mix

LOG DATA

TYPE OF LOG RUN (Circle One): No Log Run, Electric, Gamma Ray, Density, Sonic, Neutron, Other (Describe) handwritten

Name of Organization Running Log

GEOLOGIC DATA (Office Use Only)

Surface Elev.	Geologic Unit	Unit Thickness	Depth to Top
Subs. SWL	Date	Analysis	Aquifer Test

Driller's Remarks

Top of Lap Pipe or Reduction in Casing FEET. IF TELESCOPED OR MORE THAN ONE SCREEN: USE BACK PAGE

SCREEN DATA

Diameter - Inches	Length - Feet	Slot Size - Inches
2"	20'	.006
Screen Type		**Depth to Bottom - Feet**
PVC		660'

DESCRIPTION OF FORMATIONS ENCOUNTERED	FROM	TO
mud	0	40
sand	40	100
mud	100	260
sand	260	320
mud	320	330
sand	330	540
mud	540	640
sand	640	660

FORMATIONS (Continued)	FROM	TO
IF MORE SPACE IS NEEDED, USE BACK		

RECD AUG 13 2001

If well telescopes please
sketch and show depths.

GROUND LEVEL

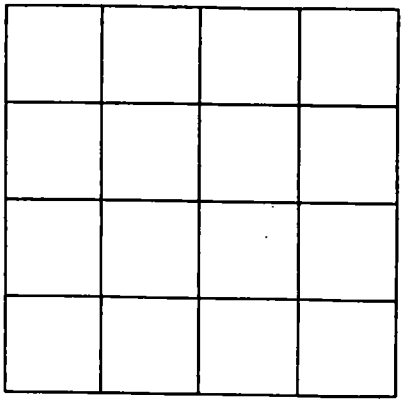

SECTION _____

Please indicate well location X.

ADDITIONAL INFORMATION

If more than one screen,
show location of each on sketch.