MISSISSIPPI DEPARTMENT OF ENVIRONMENTAL QUALITY
Office of Land and Water Resources

P. O. Box 10631
Jackson, MS 39289-0631
WATER WELL DRILLERS LOG

COUNTY WELL LOCATED: Hancock	
WELL NUMBER: S-2360	CODED:
DATE WELL COMPLETED: 6/19/01	
PERMIT NUMBER: O-839	
NAME OF DRILLING FIRM: McGill pump & well	

NAME & MAILING ADDRESS OF LANDOWNER
JASON GARCIA
9034 Cleo Smith Rd
Pass Christian, MS 39503

WELL LOCATION	SEC	TOWNSHIP	RANGE
	19	7 (N/S)	13 (E/W)

DISTANCE	DIRECTION	NEAREST TOWN
10 Miles	W of	Gulf

OTHER LANDMARK:

WELL PURPOSE: (Home) Irrigation, Municipal, Industrial, Fish Pond, etc.

PUMP DATA

PUMP TYPE (Circle One): Submersible, Turbine, (Jet), Flowing Well, Other (Describe)

POWER TYPE (Circle One): Electric, Tractor, Diesel, Gasoline, Butane, Other (Describe) H/P 1

Pump Capacity (GPM)	No. of Stages	Setting Depth
8	2	60 FT.

PUMP TEST:
Well yielded 8 GPM with a drawdown of 5 ft. after 5 hours of pumping

WELL DATA

Well Depth	Casing Diameter (In.)	Casing Length (Ft.)
180	2"	160

Type of Casing	Hole Depth	Depth to Static Water Level
PVC	180	40

TYPE OF COMPLETION: (Circle One or More): Gravel Packed, Underreamed, Telescoped, (Natural Development), Open Hole, Other (Describe)

WELL GROUTED TO A DEPTH OF 10 FEET
Type Grout (circle one): Cement, Bentonite, or Mix

LOG DATA

TYPE OF LOG RUN (Circle One): No Log Run, Electric, Gamma Ray, Density, Sonic, Neutron, Other (Describe) hand bailer

Name of Organization Running Log

GEOLOGIC DATA (Office Use Only)

Surface Elev.	Geologic Unit	Unit Thickness	Depth to Top
Subs. SWL	Date	Analysis	Aquifer Test

Driller's Remarks

Top of Lap Pipe or Reduction in Casing
FEET — IF TELESCOPED OR MORE THAN ONE SCREEN: USE BACK PAGE

SCREEN DATA

Diameter - Inches	Length - Feet	Slot Size - Inches
2"	20	.006

Screen Type	Depth to Bottom - Feet
PVC	180

DESCRIPTION OF FORMATIONS ENCOUNTERED	FROM	TO
Mixed Sand	0	160
	160	180

FORMATIONS (Continued)	FROM	TO

IF MORE SPACE IS NEEDED, USE BACK

REC'D JUN 25 2001

If well telescopes please sketch and show depths.

GROUND LEVEL

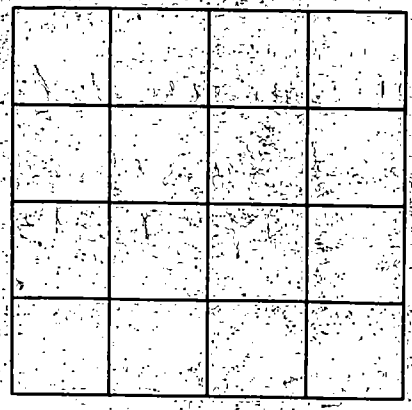

SECTION _____

Please indicate well location X.

ADDITIONAL INFORMATION

If more than one screen, show location of each on sketch.