

HAR.

MISSISSIPPI BOARD OF WATER COMMISSIONERS

K 55

11-9-63

WATER WELL DRILLERS LOG

CODED

Date: 11-9, 1963, Driller: Leonard Bess County Harrison

(Name)

(1) Owner of Land: L. R. Byrge  
(Name)

Rt 1. Box 611-A Longview Miss

Block 27 Lot 2  
(Address)

(2) Location: 1/4, 1/4, Sec 34 T7R12  
4 miles west of Gulfport  
(distance) (direction) (Nearest Town)

(3) Topography: X  
(Hilly) (Flat) (Level)

(4) Purpose of Well: Home  
(Domestic Irrigation  
Municipal, Industrial, Other)

Description & Color of Materials Sand, Clay, Red Clay, Shell, etc.	Thick- ness Feet	Depth Feet
<u>Soft mud + sand</u>	<u>21</u>	<u>21</u>
<u>Hard Blue mud</u>	<u>63</u>	<u>84</u>
<u>Fine sand</u>	<u>10</u>	<u>94</u>
<u>Hard Blue mud</u>	<u>140</u>	<u>234</u>
<u>stratified water</u>	<u>12</u>	<u>246</u>

CODED

Information upon completion of well:

(1) Diameter 2" x 1 1/4" inches.

(2) Total Depth 246 feet.

(3) Water Level 4 ft feet below top of ground.

(4) Cased to \_\_\_\_\_, Size \_\_\_\_\_.

(5) Screen: Size 1 1/4", Length 10 ft.


(6) Were any formations sealed against pollution?

\_\_\_\_\_ yes, \_\_\_\_\_ no.

If YES depth of formation \_\_\_\_\_.

Why \_\_\_\_\_.

Drillers Remarks: \_\_\_\_\_

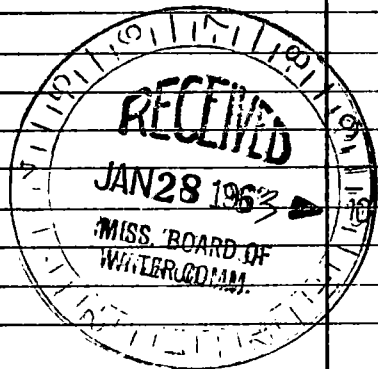

(Use Back Side)

Well No.










