HARRISON
K 145
6-15-73

MISSISSIPPI
BOARD OF WATER COMMISSIONERS
416 North State Street
Jackson, Mississippi 39201

WATER WELL DRILLERS LOG

6-15-73 19__ Sutter Well Works Harrison
date well completed — firm name — county well located

LANDOWNER: Lake Village Utilities
Box 876 - Gulfport,
LAKEWOOD ENVIRONMENT Miss.
(mailing address)

WELL LOCATION:
sec. 2 T 7 ~~N~~ S R 12 ~~E~~ W
4 miles SW of Lyman
(distance) (direction) (nearest town)

WELL PURPOSE: sub-division
(home, irrigation, municipal, industrial)

WELL COMPLETION DATA:

(1) diameter (inches) 8" x 12"
(2) total depth (feet) 741'
(3) static water level (feet) 66' below ~~above~~ top of ground.
(4) casing blk. steel 690'
(material) (depth)
8 & 12" if telescope see back.
(size)
(5) screen 50', 690'
(length) (depth to top)
8", stainless steel
(size) (material)
(6) pump 20 300
(HP) (yield gpm)
elec.
(type power)
(7) electric log no
(yes or no)
(organization running log)
(8) how well bottom plugged B.P.Valve

DRILLERS REMARKS:

description of formations encountered	from	to
Clay	0	326
Sand	326	410
Clay	410	534
Sand	534	594
Clay	594	681
Sand	681	741

CODED

JAN 30 1974
MISS. BD. OF WATER COMM

If well telescopes please sketch and show depths.

GROUND LEVEL

670' of 12" black steel

23' overlap

43' of 8" black steel

50' of 8" strainer

1' tail pipe below strainer

If more than one screen, show locations of each on sketch.

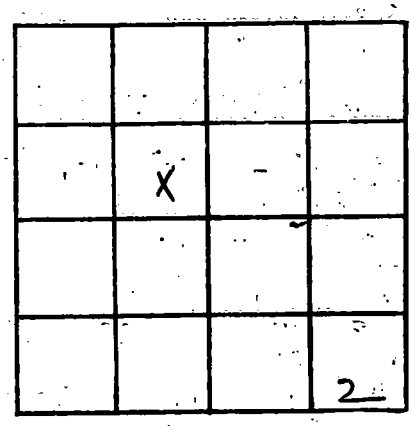

SECTION _____

Please indicate well location X.

ADDITIONAL INFORMATION