MISSISSIPPI DEPARTMENT OF NATURAL RESOURCES

Bureau of Land and Water Resources

P.O. Box 10631
Jackson, Mississippi 39209

WATER WELL DRILLERS LOG

COUNTY WELL LOCATED: Harrison	
WELL NUMBER: K 2046	CODED:
DATE WELL COMPLETED:	
PERMIT NUMBER:	
NAME OF DRILLING FIRM: Mcall Enterprises	

NAME & MAILING ADDRESS OF LANDOWNER: Bob Bond, Saucier, Miss. 39574

WELL LOCATION: SEC 35 TOWNSHIP 7 N (S) RANGE 12 E (W)

DISTANCE: 3 Miles DIRECTION: West of NEAREST TOWN: Gul.

OTHER LANDMARK:

WELL PURPOSE: Home, Irrigation, Municipal, Industrial, Fish Pond, etc.: Home

PUMP DATA

PUMP TYPE (Circle One): Submersible, Turbine, (Jet) Flowing Well, Other (Describe) _____

POWER TYPE (Circle One): (Electric) Tractor, Diesel, Gasoline, Butane, Other (Describe) _____

Pump Capacity (GPM)	No. of Stages	Setting Depth
13	2	40 FT.

PUMP TEST

Well yielded 13 GPM with a drawdown of 5 ft. after 1 hours of pumping

WELL DATA

Well Depth	Casing Diameter (In.)	Casing Length (Ft.)
520'	2"	510'
Type of Casing	**Hole Depth**	**Depth to Static Water Level**
PVC	525'	15'

TYPE OF COMPLETION: (Circle One or More): Gravel Packed, Underreamed, Telescoped, (Natural Development), Open Hole, Other (Describe) _____

Top of Lap Pipe or Reduction in Casing: FEET

IF TELESCOPED OR MORE THAN ONE SCREEN: USE BACK PAGE

LOG DATA

TYPE OF LOG RUN (Circle One): No Log Run, Electric, Gamma Ray, Density, Sonic, Neutron, Other (Describe) _____

Name of Organization Running Log:

GEOLOGIC DATA (Office Use Only)

Surface Elev.	Geologic Unit	Unit Thickness	Depth to Top
Subs. SWL	Date	Analysis	Aquifer Test

Driller's Remarks:

SCREEN DATA

Diameter - Inches	Length - Feet	Slot Size - Inches
2"	10'	6 ths
Screen Type	**Depth to Bottom - Feet**	
PVC	520'	

DESCRIPTION OF FORMATIONS ENCOUNTERED	FROM	TO
mud	0	20
Sand	20	40
mud	40	180
Sand	180	200
mud	200	420
Sand	420	430
mud	430	480
Sand	480	520

FORMATIONS ENCOUNTERED	FROM	TO

IF MORE SPACE IS NEEDED, USE BACK

RECEIVED
NOV 3 1986
Department of Natural Resources
Bureau of Land & Water Resources

If well telescopes please sketch and show depths.

GROUND LEVEL

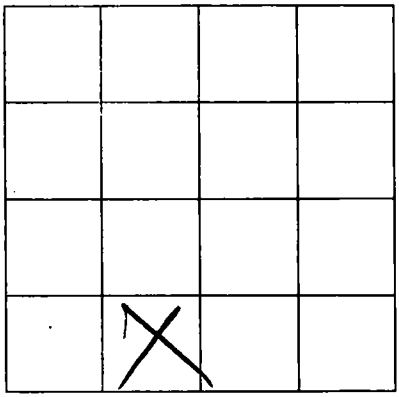

SECTION _____

Please indicate well location X.

ADDITIONAL INFORMATION

If more than one screen, show location of each on sketch.