MISSISSIPPI DEPARTMENT OF NATURAL RESOURCES

Bureau of Land and Water Resources

P.O. Box 10631
Jackson, Mississippi 39209

WATER WELL DRILLERS LOG

COUNTY WELL LOCATED: Harrison	PERMIT NUMBER: 0239
WELL NUMBER: K 2050 — CODED	NAME OF DRILLING FIRM: MCGILL PUMP & WELLS RT1 BOX 1643 CANAL RD GULPT, MS 39503
DATE WELL COMPLETED: 12-29-86	

NAME & MAILING ADDRESS OF LANDOWNER: Joyce Rivera, 1339 E 2nd St, Gulpt Ms.

WELL LOCATION: SEC 11 TOWNSHIP 7 (N/S) RANGE 12 (E/W)

DISTANCE 3 Miles DIRECTION N/W of NEAREST TOWN Canal Rd

OTHER LANDMARK: By Landon

WELL PURPOSE: Home, Irrigation, Municipal, Industrial, Fish Pond, etc.

PUMP DATA

PUMP TYPE (Circle One): Submersible, Turbine, Jet, Flowing Well, Other (Describe) 1hp Sta-rite

POWER TYPE (Circle One): Electric, Tractor, Diesel, Gasoline, Butane, Other (Describe)

Pump Capacity (GPM)	No. of Stages	Setting Depth
10	2	90' FT.

PUMP TEST: Well yielded 10 GPM with a drawdown of 4 ft. after 1 hours of pumping

WELL DATA

Well Depth	Casing Diameter (In.)	Casing Length (Ft.)
560'	2"	560'

Type of Casing	Hole Depth	Depth to Static Water Level
PVC	560'	70'

TYPE OF COMPLETION: (Circle One or More): Gravel Packed, Underreamed, Telescoped, Natural Development, Open Hole, Other (Describe)

Top of Lap Pipe or Reduction in Casing: FEET — IF TELESCOPED OR MORE THAN ONE SCREEN: USE BACK PAGE

SCREEN DATA

Diameter - Inches	Length - Feet	Slot Size - Inches
2"	10'	6 ths

Screen Type	Depth to Bottom - Feet
PVC	560'

LOG DATA

TYPE OF LOG RUN (Circle One): No Log Run, Electric, Gamma Ray, Density, Sonic, Neutron, Other (Describe)

Name of Organization Running Log

GEOLOGIC DATA (Office Use Only)

Surface Elev.	Geologic Unit	Unit Thickness	Depth to Top
Subs. SWL	Date	Analysis	Aquifer Test

Driller's Remarks

RECEIVED
JAN 14 1987
Department of Natural Resources
Bureau of Land & Water Resources

DESCRIPTION OF FORMATIONS ENCOUNTERED	FROM	TO
mud	0	180
Sand	180	220
mud	220	520
Sand	520	560

DESCRIPTION OF FORMATIONS	FROM	TO

IF MORE SPACE IS NEEDED, USE BACK

If well telescopes please sketch and show depths.

GROUND LEVEL

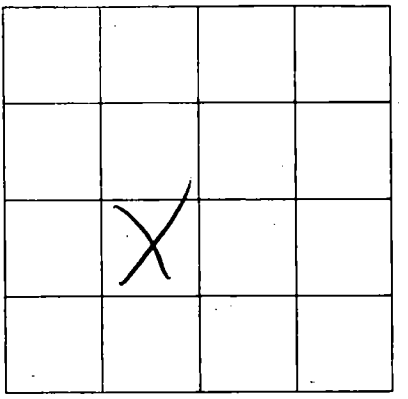

SECTION _____

Please indicate well location X.

ADDITIONAL INFORMATION

If more than one screen, show location of each on sketch.